


Section 31 Township 18 Range 10W

Well No. #2 Reif "B"

Company Sohio & Derby Oil

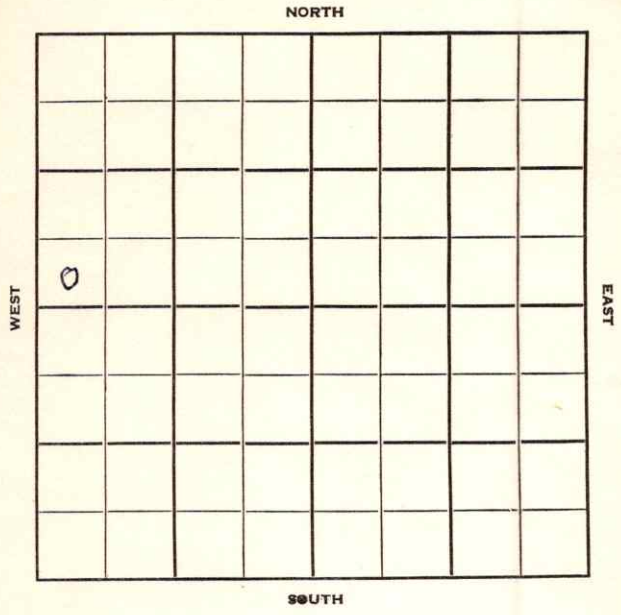

Rice

Sec. 31 Twp. 18 R. 10W

Well No. #2 Reif "B" Farm _____

Sohio & Derby Oil Company _____

Strain Drlg. -Contr. Contractor _____

Mary Ida Pool


_____ Ft. from N. Line

330' Ft. from S. Line

_____ Ft. from E. Line

330' Ft. from W. Line

SW SW NW

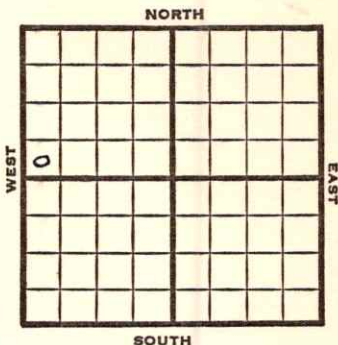

1951

Elev. 1752'

REPORT

6/6

8" @ 492

Anhy 492

Drlg. 2800'

6/27

Oil Well TD 3294

8" @ 492

Anhy 492 Lans. 2958

Arb. 3293

5" @ 3294 TD 3294

CO to 3246 12/3050-54 FU 500'

oil 3000 A 57 boph Comp. F/573

bopd

COMPLETED

County Rice State Kansas

Sec. 31 (Blk. 18 (Sur. 10W (Twp.) 10W Map No.

Operator Sohio & Derby Oil

Well No. 2 Farm Reif "B"

Elev. 1752 Location SWSW NW

330 Ft. From S Line NW

330 Ft. From W Line Quarter

1st. Report JUN 6 1951

Completion _____

Remarks _____

Strain Drlg. - Contr.

Spudding Date _____

Drlg. Data Mary Ida Pool

8" @ 492 Anhy 492 drlg. 2800

J. E. TYRA

