

ELK

Map No. Kansas Sec. 27 Twp. 31 R. 11^E

Well No. 1 Per Angel Farm

Elk County Dev Company


NORTH

200 Ft. from N. Line

..... Ft. from S. Line

200 Ft. from E. Line

..... Ft. from W. Line

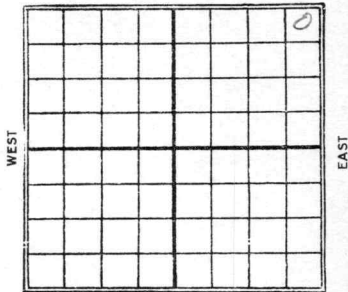

Date 1/27

REPORT

1/8

Abandoned 1962

4 KANSAS

Map No. _____ Sec. 27 Twp. 31 R. 11

Well No. 1 Len Berger

Polk County Des Co Company

Contractor

FIRST REPORTS

SECTION PLAT

200 Ft. from N. Line

Ft. from S. Line

200 Ft. from E. Line

Ft. from W. Line

			o
ABANDONED			

COMPLETED

Location _____

Rig up _____

Drilling and Remarks:

RECORD

Cased _____ in., _____ ft.

Sand _____

Gas _____

Oil _____

Total Depth 1962

PRODUCTION

1st 24 hrs. Nat. _____

1st 24 hrs. after shot _____

Gas _____ Cu. Ft.

Dry Hole ✓

Abandoned ✓

Date

JAN 8 1927

192

CHAS. L. SHERWOOD

Scout