

EMK

Map No. *Kansas* Sec. *29* Twp. *31* R. *11*


Well No. *1 La Valle* Farm
R. G. Gillespie Company

250 Ft. from N. Line

..... Ft. from S. Line

250 Ft. from E. Line

..... Ft. from W. Line

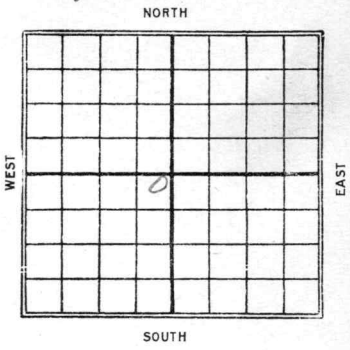

Date *1921*

REPORT

1/8 Sand 1952-1969
2 1/4 m Gas

4 KANSAS 29 31 R. 11^W
Map No. Sec. Twp. R.

Wells No. 1 La Ville

H. S. Gillespie Company

Contractor

FIRST REPORTS

SECTION PLAT

250 Ft. from N. Line

Ft. from S. Line

250 Ft. from E. Line

Ft. from W. Line

COMPLETED

	0		

Location

Rig up

Drilling and Remarks:

RECORD

Cased in, ft.

Sand 1952-1969

Gas

Oil

Total Depth 1969

PRODUCTION

1st 24 hrs. Nat.

1st 24 hrs. after shot

Gas 2 1/4 M Cu. Ft.

Dry Hole

Abandoned

Date

JAN 8 1927

CHAS. L. SHERWOOD

192

Scout