

Section 32 Township 13 Range 14 W

Well No. #1 Mai

Company Producers Pipe & Supply

NORTH

WEST

EAST

0							

SOUTH

Russell

Sec. 32 Twp. 13 R. 14W

Well No. #1 Mai Farm

Producers Pipe & Supply Company


Murfin Drlg. Contr. Contractor

\_\_\_\_\_ Ft. from N. Line

990' Ft. from S. Line

\_\_\_\_\_ Ft. from E. Line

330' Ft. from W. Line

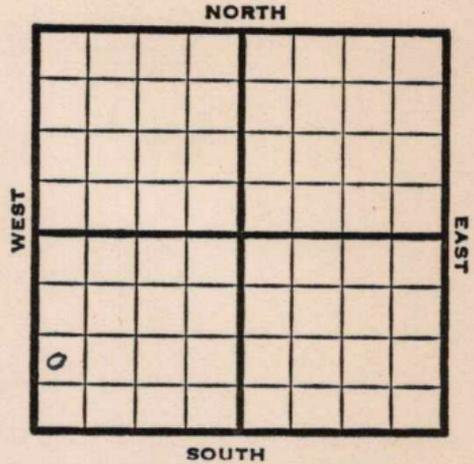

NW SW SW

1951

**Elev. 1860' REPORT**

1/17

Spud 1-12-51  
**Anhy 897'**  
8" @ 902'

3/14

Spud 1-12-51  
Oil Well TD 3297  
**Anhy 897'**  
8" @ 902' **Heeb. 2971**  
**Lans. 3020 Arb. 3292**  
5" @ 3290' TD 3297  
S/5 boph Comp. 50 bopd

**COMPLETED**



