


Map No. 15 Sec. 22 Twp. 31 R. 11

Well No. 1-7 Finley Farm  
Abell & Byington Company

NORTH

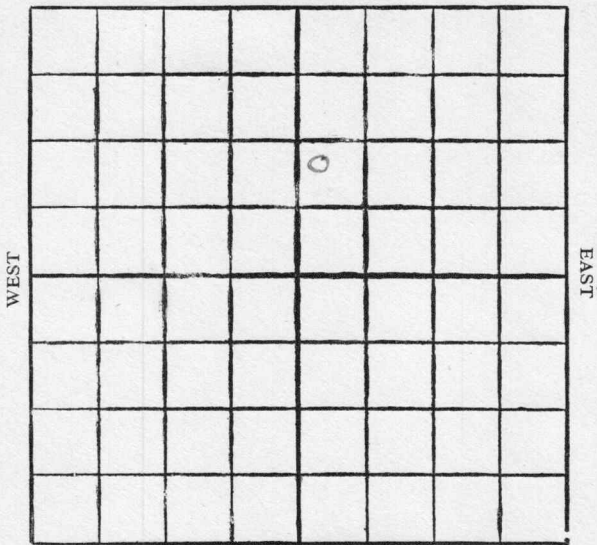

SOUTH

Location .....

Drilling Remarks

.....

.....

RECORD

Cased..... in. .... ft.

Sand .....

Gas .....

Oil .....

Total Depth.....

Rig Up.....

Drilling Remarks

.....

.....

PRODUCTION

1st 24 hrs. Nat.....

1st 24 hrs. after shot.....

Gas..... cu. ft.

Dry Hole.....


Abandoned.....

ELK

Map No. Kansas Sec. 22 Twp. 31 R 11 E

Well No. 1 Finley Farm  
Abell & Byington Company

NORTH

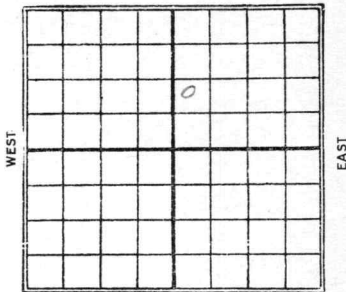

..... Ft. from N. Line

1120 Ft. from S. Line

..... Ft. from E. Line

200 Ft. from W. Line

SOUTH

Date

REPORT

1927

1/8 Sand 995-1010  
377 Gas

Elks

8

4 KANSAS  
 Map No. \_\_\_\_\_ Sec. 22 Twp. 31 R. 11

Well No. 1 Finley \_\_\_\_\_

Abel & Byington \_\_\_\_\_ Company

\_\_\_\_\_ Contractor

FIRST REPORTS

SECTION PLAT

\_\_\_\_\_ Ft. from N. Line

1120 \_\_\_\_\_ Ft. from S. Line

\_\_\_\_\_ Ft. from E. Line

200 \_\_\_\_\_ Ft. from W. Line

COMPLETED

		0	

Location \_\_\_\_\_

Rig up \_\_\_\_\_

Drilling and Remarks:

Gas well

RECORD

Cased \_\_\_\_\_ in., \_\_\_\_\_ ft.

Sand 995-1010 \_\_\_\_\_

Gas \_\_\_\_\_

Oil \_\_\_\_\_

Total Depth 1010 \_\_\_\_\_

PRODUCTION

1st 24 hrs. Nat. \_\_\_\_\_

1st 24 hrs. after shot \_\_\_\_\_

Gas 3 ~~4~~ \_\_\_\_\_ Cu. Ft.

Dry Hole \_\_\_\_\_

Abandoned \_\_\_\_\_

Date

JAN 8 1927

CHAS. L. SHERWOOD

192

Scout