


Section 31 Township 18 Range 10 WWell No. # 1 MooneyCompany B & R Drlg.

NORTH

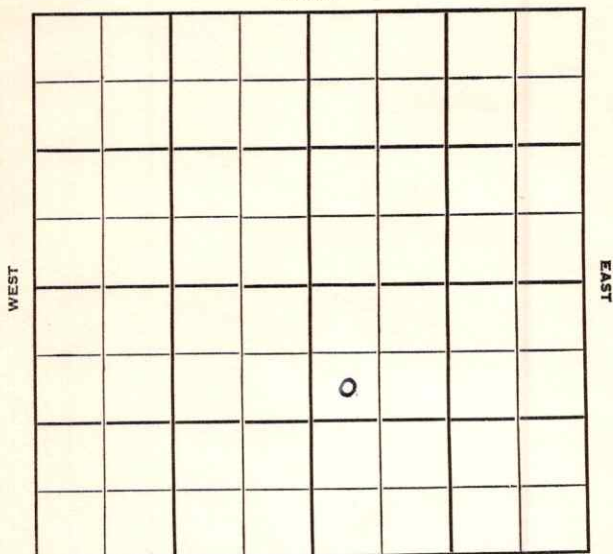

SOUTH

Rice

KANSAS

Sec. 31 Twp. 18 R. 10 W ✓

Well No. # 1 Mooney Farm

B & R Drlg. Company

Contractor

Mary Ida Pool

990 Ft. from N. Line


Ft. from S. Line

Ft. from E. Line

330 Ft. from W. Line

SW NW SE

Sohio farmout

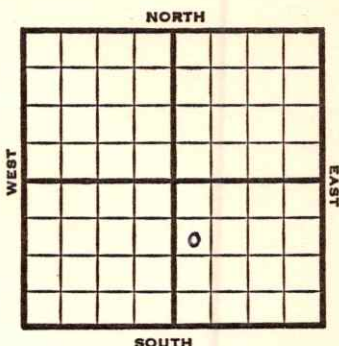

1951

Elev. 1756'

REPORT

3/7

Set surface

5/9

Spud 3-5-51

Oil well TD 3306' 8" @ 250

Anhy 484' Top. 2583' Heeb 2838'

Br. line 2956' Lans. 2977',

Cong. 3259', Arb. 3292'

5" @ 3292' TD 3300'


SO 3298-3300' DD 3304'

SO 3302-04' 1 BOPH DD 3306'

500 A S/7 BOPH

Comp. 204 BOPD 22% water


COMPLETED

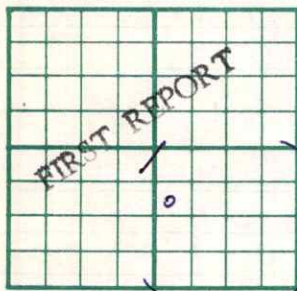County Rice State KansasSec. 31 (Blk. Twp.) 18 (Sur. Rge.) 10W Map No.Operator B & R Drlg.Well No. 1 Farm MooneyElev. Location SW NW SE990 Ft. From N Line SE330 Ft. From W Line Quarter1st. Report MAR 7 1951

Completion

Remarks Schio farmoutSpudding Date 3-5-51Drlg. Data Mary Ida PoolSet surface

J. E. TYRA

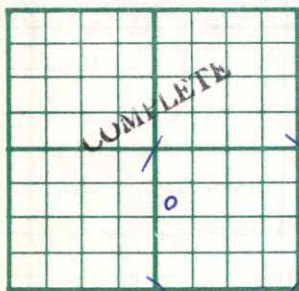County Rice State KansasSec. 31 (Blk.
Twp.) 18 (Sur.
Rge.) 10W Map No.Operator B & R Drlg.Well No. 1 Farm MooneyElev. 1756 Location SW NW SE990 Ft. From N Line SE330 Ft. From W Line Quarter1st. ReportCompletion MAY 9 1951Remarks Mary Ida PoolSpudding Date 3-5-51Drlg. Data Oil well TD 33068" @ 250 Anhy 484 Top. 2583Heeb. 2838 Br. lime 2956 Lans. 2977Cong. 3259 Arb. 3292 5" @ 3292TD 3300 SO 3298-3300 DD 3304SO 3302-04 1 boph DD 3306 500 AS/ 7 boph Comp. 204 bopd 22% water

J. E. TYRA