

KANSAS

Rice

Section 31 Township 18 Range 10W


Well No. #1 Reif "B"

Company Sohio & Derby Oil

NORTH

WEST

EAST

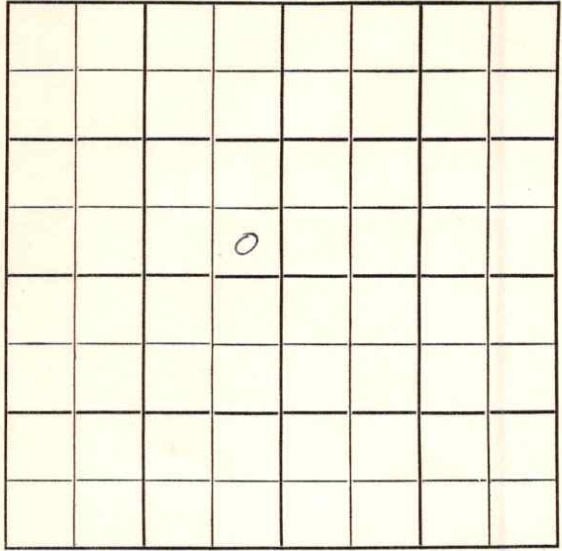

SOUTH

Rice

KANSAS

Sec. 31 Twp. 18 R. 10W

Well No. #1 Reif "B" Farm

Sohio & Derby Oil Company

Penguin Drlg. - Contr. Contractor

Mary Ida Pool


 Ft. from N. Line

330' Ft. from S. Line

330' Ft. from E. Line

 Ft. from W. Line

SE SE NW

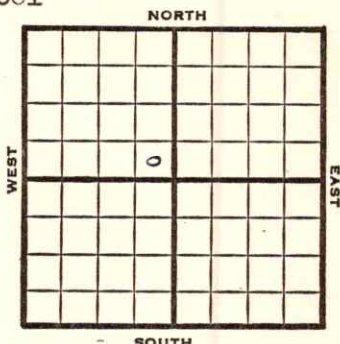

1950 **Elev 1742'** REPORT

11/22 MIR

1951

1/17

Spud 11-21-50

8" @ 311

Top 2538

DST 2741-70 opn 1 hr rec 5' free oil
60' socm

Lans 2939

DST 3027-45 opn 20 min rec 330' oil

DST 3071-88 opn 1 hr rec 12' socm

DST 3110-25 opn 1 hr rec 549' hgcm
65' ocm

Arb 3251-56

5" @ 3253

TD 3267

S/40 goph 500 A

S/45 go 3 bwph 1500 A

S/1½ boph

15% water DD 3271

S/60 go 3 gwph

DD 3275


S/2 boph 5% water 1000 A

S/7 boph

Comp 212 bopd

Completed TD 3275'

COMPLETED

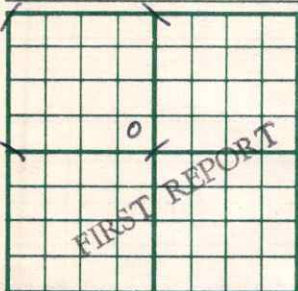County Rice State KansasSec. 31 (Blk.) 18 (Sur.) 10W Map No.Operator Sohio & Derby OilWell No. 1 Farm Reif "B"Elev. Location SE SE NW330 Ft. From S Line NW330 Ft. From E Line Quarter1st. Report NOV 22 1950

Completion

Remarks

Penguin Drlg. - Contr.

Spudding Date

Drlg. Data Mary Ida PoolM I R


J. E. TYRA

County Rice State Kansas
 Sec. 31 (Blk.
Twp.) 18 (Sur.
Rge.) 10W Map No.

Operator Sohio & Derby Oil

Well No. 1 Farm Reif "B"

Elev. 1742 Location SE SE NW

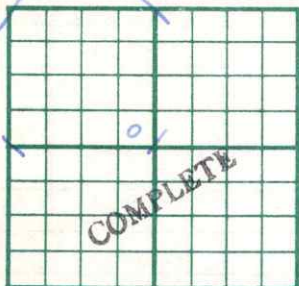

330 Ft. From S Line NW

330 Ft. From E Line Quarter

1st. Report

Completion JAN 17 1951

Remarks Mary Ida Pool

Penguin Drlg. - Contr.

Spudding Date 11-21-50

Drlg. Data Oil well TD 3275

8" @ 311 Top. 2538 DST 2741-70

open 1 hr. Rec. 5' free oil 60' socm

Lans. 2939 DST 3027-45 open 20 min.

Rec. 330' oil DST 3071-88 open 1 hr.

Rec. 12' socm DST 3110-25 open 1 hr.

Rec. 549' hgcm 65' ocm Arb. 3251-56

5" @ 3253 TD 3267 S/ 40 goph 500 A

S/ 45 go 3 gwph 1500 A S/ 1 1/2 boph

15% water DD 3271 S/ 60 go 3 gwph

DD 3275 S/ 2 boph 5% water 1000 A

S/ 7 boph Comp. 212 bopd

J. E. TYRA