


Section 31 Township 18 Range 10 W

Well No. # 3 Reif "B"

Company Sohio & Derby Oil

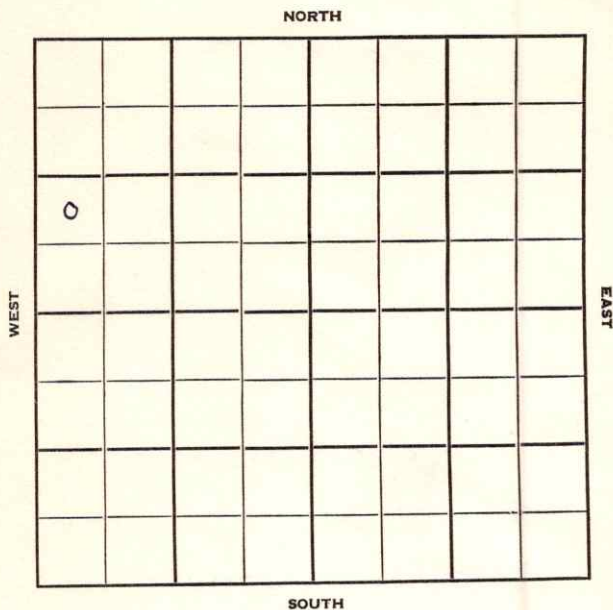

Rice

**KANSAS**

Sec. 31 Twp. 18 R. 10W

Well No. #3 Reif "B" Farm \_\_\_\_\_

Sohio & Derby Oil Company \_\_\_\_\_

Mary Ida Pool Contractor \_\_\_\_\_


\_\_\_\_\_ Ft. from N. Line

990' \_\_\_\_\_ Ft. from S. Line

\_\_\_\_\_ Ft. from E. Line

330' \_\_\_\_\_ Ft. from W. Line

NW SW NW

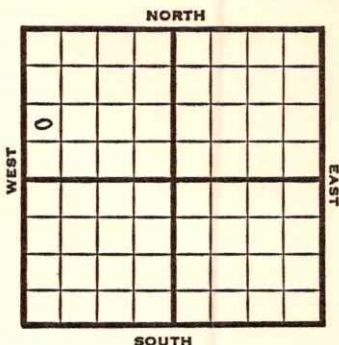

1951

**Elev. 1754'** REPORT

5/16

Spud 5-12-51  
8" @ 317  
**Anhy 492**  
Drlg. 1650'

7/3

Spud 5-12-51 Oil well TD 3294'  
8" @ 317 **Anhy 492'** **Heeb 2831'**  
**Lans. 2966'**  
DST 3050-66 open 1/2 hr. rec 210' MCO & G  
180' free oil,  
**Cong. 3266'**  
DST 3137-50 open 1 hr. rec 18' mud  
**Arb. 3288'** TD 3294' 5" @ 3290'  
24/3054-62 12 GW 25 GOPH 500 A  
S/13 BFPH 14% water  
Comp. 372 BOPD 10% water

**COMPLETED**

County Rice State KansasSec. 31 (Blk. 18) (Sur. 10W) (Twp.) (Rge.) Map No.Operator Sohio & Derby OilWell No. 3 Farm Reif "B"Elev. Location NW SW NW

0					

990 Ft. From S Line NW330 Ft. From W Line Quarter1st. Report MAY 16 1951

Completion

Remarks

Spudding Date 5-12-51Drlg. Data Mary Ida Pool8" @ 317 Anhy 492 drlg. 1650

J. E. TYRA

