

Butler


Form 51-5M-3-26-22544

Map No. TRANS Sec. 3 Twp. 28 R. 6

Well No. 2 Blakeman Farm

Tom C. Johnson Company

NORTH

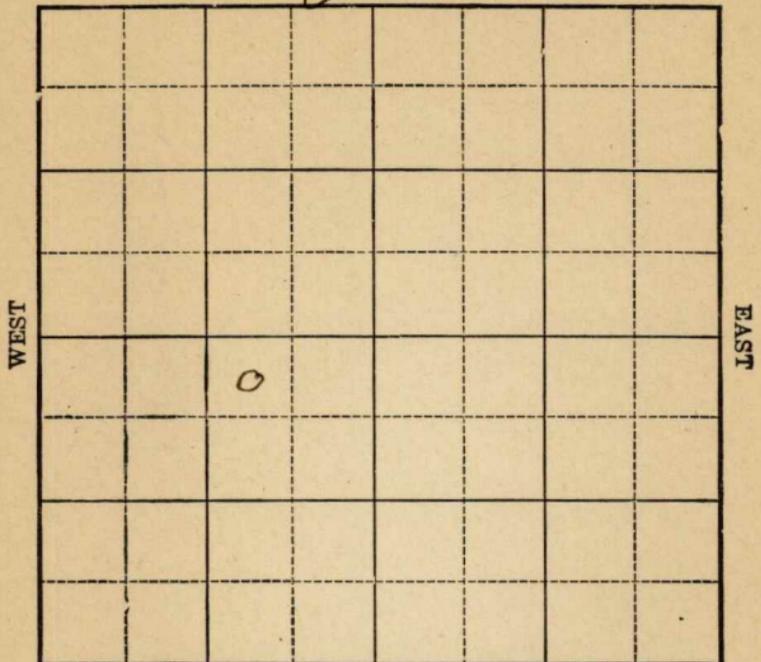

Location _____

Drilling Remarks _____

Rig Up _____

Drilling Remarks _____

RECORD

Cased _____ in. _____ ft.

Sand _____

Gas _____

Oil _____

Total Depth _____

PRODUCTION

1st 24 hrs. Nat. _____

1st 24 hrs. after shot _____

Gas _____ cu. ft.

Dry Hole _____

Abandoned _____

Butler Co

Map No. Kansas Sec. 3 Twp. 28 R. 6

Well No. 2 Blakeman Farm


Tom C. Johnson Company

330 Ft. from N. Line

_____ Ft. from S. Line

990 Ft. from E. Line

_____ Ft. from W. Line

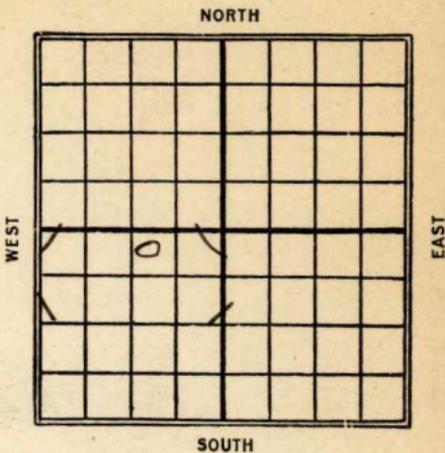

Date	REPORT
1926	
6/30	Location
7/8	Bldg rig
7/15	Rigging up
7/22	Drg 500
7/28	_____
8/4	Drg 1300
8/11	" 2115
8/18	" 2375
8-25	3m gas 2670-2705
	top line 2784'
	6" 2791' Drg.
8-31	zap line 2774' 6" 2781' sdg
	line 2781-90' show 2781-84'
	2400' fluid in hole. Drg 2760'
9/15	Silc. line 3047-54
	3m gas. 2670-2705
	top line 2774'
	430 Bbls nat

Butler

Map No. *K11* KANSAS Sec. *3* Twp. *28* R. *6*

Well No. *2* *Bladen*

Tom. C. Johnson Company

Contractor

FIRST REPORTS

SECTION PLAT

220


----- Ft. from N. Line

----- Ft. from S. Line

990

----- Ft. from E. Line

----- Ft. from W. Line

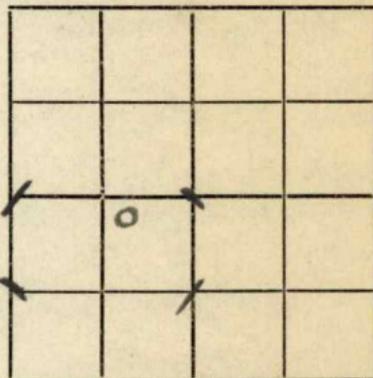

Location *✓* -----

Rig up -----

Drilling and Remarks:

RECORD

Cased ----- in., ----- ft.

Sand -----

Gas -----

Oil -----

Total Depth -----

PRODUCTION

1st 24 hrs. Nat. -----

1st 24 hrs. after shot -----

Gas ----- Cu. Ft.

Dry Hole -----

Abandoned -----

Date

JUN 30 1926

CHAS. L. SHERWOOD

192

Scout

Butler

11 **KANSAS** Sec. *3* Twp. *28* R. *6*

Well No. *2 Blake man*

Jan. C. Johnson Company

Contractor

COMPLETED

SECTION PLAT

330 Ft. from N. Line

Ft. from S. Line

990 Ft. from E. Line

Ft. from W. Line

	0		

Location *5th line*

Rig up

Drilling and Remarks:

3 1/2 hrs 2670-2705

Tap line 2774'

RECORD

Cased *30* in., ft.

Sand *2047-54*

Gas

Oil

Total Depth *2054'*

PRODUCTION

1st 24 hrs. Nat. _____

1st 24 hrs. after shot _____

Gas _____ Cu. Ft.

Dry Hole _____

Abandoned _____

430 lbs returned

Date

SEP 15 1926

CHAS. L. SHERWOOD

192

Scout