

KANSAS

Russell


Section 32 Township 13 Range 14W

Well No. 3 Miller "F"

Company Cities Service

Hall-Gurney Pool

NORTH

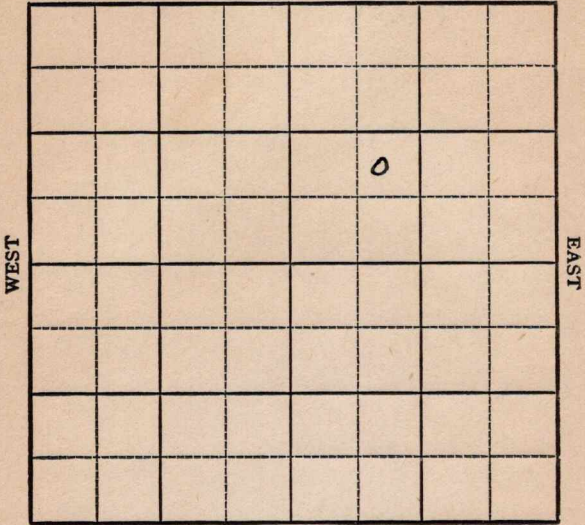

SOUTH



Sec. 32 **KANSAS** Twp. 13 R. 14W

Well No. #3 Miller "F" Farm

Cities Service

Company


Hall-Gurney Pool

_____ Ft. from N. Line

990' Ft. from S. Line

_____ Ft. from E. Line

990' Ft. from W. Line

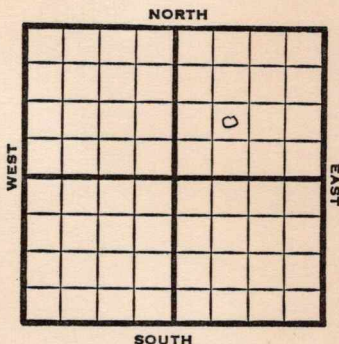

NE SW NE

1948

Elev. 1867' REPORT

12/15

8" @ 409'

Drlg. 501'

Drlg 2900'

12/22

12/29

Lansing 3035'

Arb. 3308-11

TD 3311

5" @ 3309'

1/5

" "

1/12

TD 3342, 830' w 14 hrs

PB 3299 21 shots 3269-75

No shows. 54 shots 3248-66 NS

1/19

Drlg 3510'

1/26

Arb. 3308'

5" @ 3309'

Reagan 3520'

SWD

TD 3529'

COMPLETED

Map No. _____ Sec. 32 Twp. 13 R. 14W

Well No. 3 Miller "F"

_____ Cities Service _____ Company

_____ FIRST REPORT _____ Contractor

NE SW NE

SECTION PLAT

_____ Ft. from N. Line

990 Ft. from S. Line

_____ Ft. from E. Line

990 Ft. from W. Line

		o	

Russell County

Location: _____

Rig up _____

Drilling and Remarks:

8" @ 409

drlg. 501

RECORD

Cased _____ in., _____ ft.

Sand _____

Gas _____

Oil _____

Total Depth _____

PRODUCTION

1st 24 hrs. Nat. _____

1st 24 hrs. after shot _____

Gas _____ Cu. Ft.

Dry Hole _____

Abandoned _____

Date

DEC 15 1948

19

S. J. LEWIS

Scout

