Form 51—5M—10-26—Mid-West

Map No. 55 Sec. 29 Twp. 31 R. 11E

Well No. 1-Welch Farm

R. D. Gillispie Company

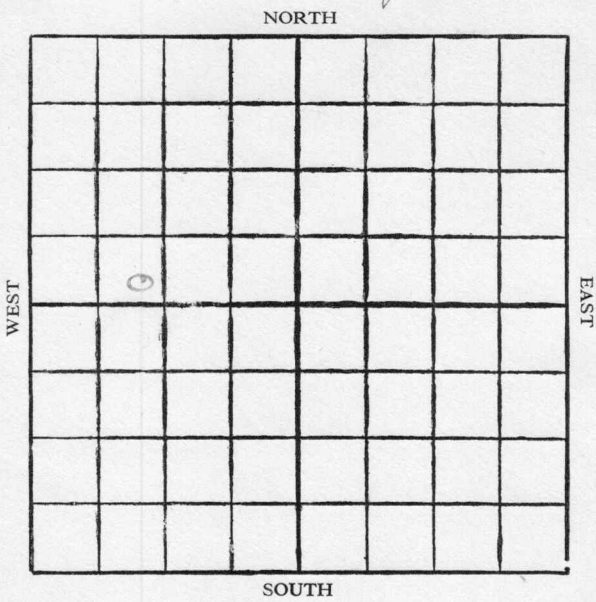

Location

Drilling Remarks

Rig Up

Drilling Remarks

RECORD

Cased ..... in. ..... ft.

Sand

Gas

Oil

Total Depth

PRODUCTION

1st 24 hrs. Nat.

1st 24 hrs. after shot

Gas ..... cu. ft.

Dry Hole

Abandoned

Form 252A—5M—10-26—24951

Elko

Map No. Kansas Sec. 29 Twp. 31 R 11

Well No. 1 Welch Farm

R. G. Gillespie Company

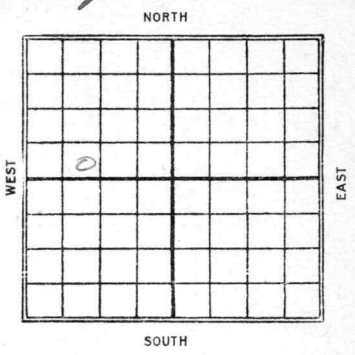

____ Ft. from N. Line

200 Ft. from S. Line

____ Ft. from E. Line

1120 Ft. from W. Line

Date	REPORT
1927	
1/8	Sand 1950–1960 2nd Gas

Form 26—1M Bks.—3-23—11959. Kelly W

Map No. 4 KANSAS Sec. 29 Twp. 31 R. 11

Well No. 1 Welch

L L Gillespie Company

Contractor

FIRST REPORTS

Ft. from N. Line

200 Ft. from S. Line

Ft. from E. Line

1120 Ft. from W. Line

COMPLETED

SECTION PLAT

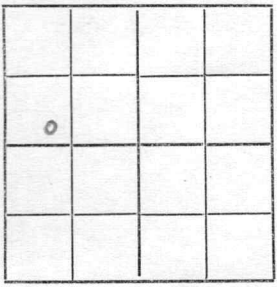

Location

Rig up

Drilling and Remarks:

RECORD

Cased in., ft.

Sand 1950- 1960

Gas

Oil

Total Depth 1960

PRODUCTION

1st 24 hrs. Nat.

1st 24 hrs. after shot

Gas 2 M Cu. Ft.

Dry Hole

Abandoned

Date

JAN 8 1927 CHAS. L. SHERWOOD

192 Scout