


Section 33 Township 13 Range 14W

Well No. 1 Boxberger

Company Phil-Han

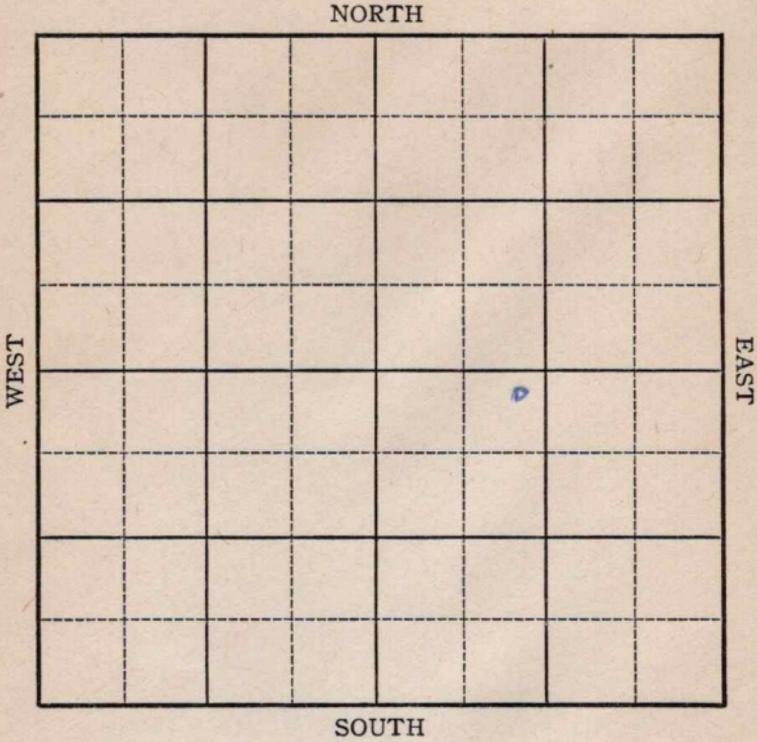

Sec. 33 Twp. 13 R. 14-W

Well No. #1 Boxberger Farm

Phil-Han Company

Wildcat


330 Ft. from N. Line

\_\_\_\_\_ Ft. from S. Line

\_\_\_\_\_ Ft. from E. Line

990 Ft. from W. Line

*Elev. 1861'*

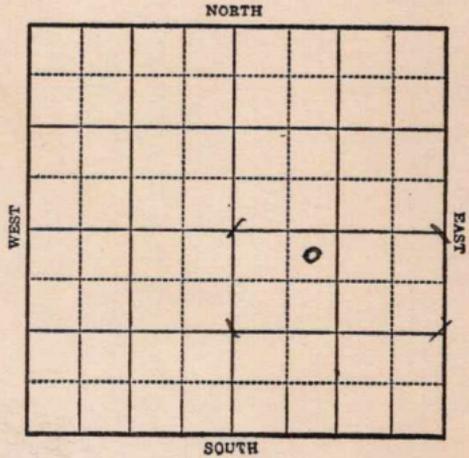

1942

R E P O R T

10/21 Cable

10/28 Rigging up

11/4 15" @ 380 Drlg.

11/11 **Anhy 900**  
12" @ 603  
10" @ 904  
Drlg. 2035'

11/18 Drlg. 2765  
8" @ 2498  
**Topeka 2752**

11/24 **Lans 2977**  
**Dodge 2935**  
**Arb. 3242**  
TD 3245 SO  
6" @ 3242 $\frac{1}{2}$  Rust

12/2 Arb 3317-24 TD  
Water SD

12/9 **Arb. 3317**  
water  
T.D. 3324

**ABANDONED**

Russell

KANSAS

Map No. 72 Sec. 33 Twp. 13 R. 14W

Well No. 1 Boxberger

Phil-Han Company

FIRST REPORT Contractor

NE NW SE


SECTION PLAT

330 Ft. from N. Line

\_\_\_\_\_ Ft. from S. Line

\_\_\_\_\_ Ft. from E. Line

990 Ft. from W. Line

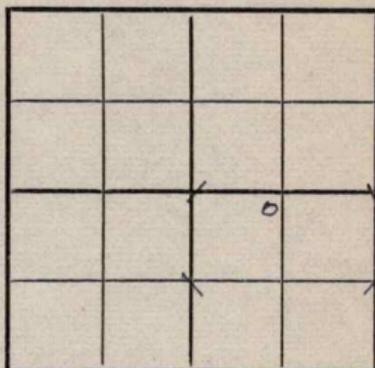

WILDCAT

Location \_\_\_\_\_

Rig up \_\_\_\_\_

Drilling and Remarks:

Cable

RECORD

Cased \_\_\_\_\_ in., \_\_\_\_\_ ft.

Sand \_\_\_\_\_

Gas \_\_\_\_\_

Oil \_\_\_\_\_

Total Depth \_\_\_\_\_

PRODUCTION

1st 24 hrs. Nat. \_\_\_\_\_

1st 24 hrs. after shot \_\_\_\_\_

Gas \_\_\_\_\_ Cu. Ft.

Dry Hole \_\_\_\_\_

Abandoned \_\_\_\_\_

Date

OCT 21 1942 19

S. J. LEWIS Scout

Russell

Map No. 72 Sec. 33 Twp. 13 R. 14W

Well No. 1 Boxberger

Phil-Han Company

ABANDONED Contractor

NE NW SE

SECTION PLAT

330 Ft. from N. Line

\_\_\_\_\_ Ft. from S. Line

\_\_\_\_\_ Ft. from E. Line

990 Ft. from W. Line

		o	v

WILDCAT

Location \_\_\_\_\_

Rig up \_\_\_\_\_

Drilling and Remarks:

*Cr & 3317*

*Water.*

RECORD

Cased \_\_\_\_\_ in., \_\_\_\_\_ ft.

Sand \_\_\_\_\_

Gas \_\_\_\_\_

Oil \_\_\_\_\_

Total Depth 3324

PRODUCTION

1st 24 hrs. Nat. \_\_\_\_\_

1st 24 hrs. after shot \_\_\_\_\_

Gas \_\_\_\_\_ Cu. Ft.

Dry Hole \_\_\_\_\_

Abandoned \_\_\_\_\_

Date

DEC 9 1942

S. J. LEWIS Scout