

KANSAS


Russell County

FORM 51 5M PETROL

Section 33 Township 13 Range 14W

Well No. 1 Boxberger

Company Derby Oil etal

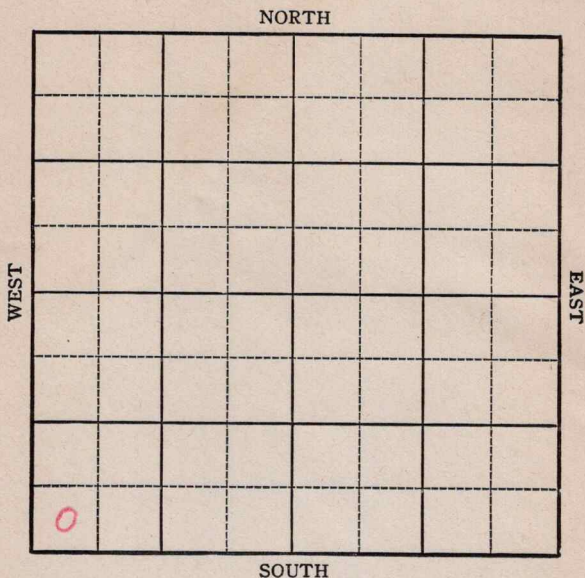

KANSAS

Sec. 33 Twp. 13 R. Russell
14W
Well No. 1 Boxberber Farm
Derby Oil etal Company

Russell

Ft. from N. Line

330


Ft. from S. Line

Ft. from E. Line

330

Ft. from W. Line

SW/4

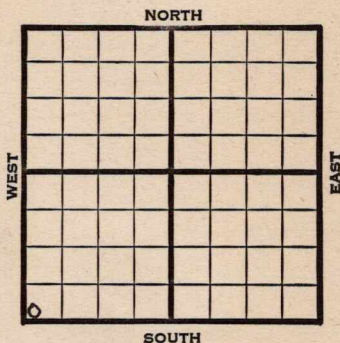

1945

Elev. 1852

REPORT

5/9 8" -405 WOC

5/17 Drlg. 2465

5/23 **Lans** 2997

Arb 3320

TD 3358'

ABANDONED


Kansas Pool Name RussellMap No. 72 Sec. 33 Twp. 13 R. 14WWell No. 1 BoxbergerDerby Oil etal Company

FIRST REPORT

Contractor

SW/c

SECTION PLAT

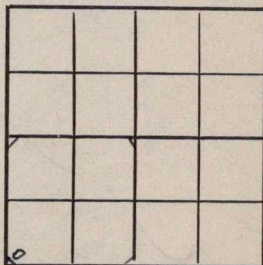 Ft. from N. Line330 Ft. from S. Line Ft. from E. Line330 Ft. from W. Line

Russell

Location Rig up Drilling and Remarks:
8" - 405 WOC

RECORD

Cased in., ft.Sand Gas Oil Total Depth

PRODUCTION

1st 24 hrs. Nat. 1st 24 hrs. after shot Gas Cu. Ft.Dry Hole Abandoned

Date


MAY 9 1945 19S. J. LEWIS Scout

Kansas Pool Name RussellMap No. 72 Sec. 33 Twp. 13 R. 14WWell No. 1 BoxbergerDerby Oil etal

Company

ABANDONED

Contractor

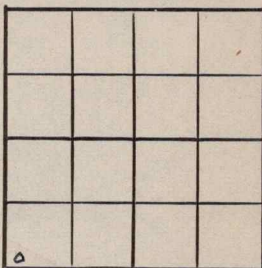SW/cE 1, 1852
SECTION PLAT Ft. from N. Line330 Ft. from S. Line Ft. from E. Line330 Ft. from W. LineRussellLocation Rig up

Drilling and Remarks:

Lane 2887Cor 3320

RECORD

Cased in., ft.Sand Gas Oil Total Depth 3358

PRODUCTION

1st 24 hrs. Nat. 1st 24 hrs. after shot Gas Cu. Ft.Dry Hole Abandoned

Date

MAY 23 194519S. J. LEWISScout