


Kansas

Well No. 6 - Blakeman Farm

Mid-Kansas Company

NORTH

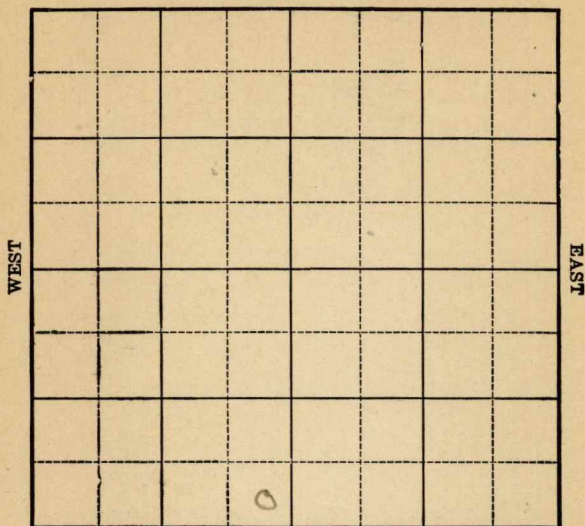

SOUTH

Rig Up.....

Drilling Remarks

PRODUCTION

1st 24 hrs. Nat.-----

1st 24 hrs. after shot_____

Gas _____ cu. ft.

Dry Hole

Abandoned -----


Kansas

Map No. _____ Sec. 3 Twp. 28 R. 6Well No. 6-Blakeman FarmMid-Kansas Company

_____ Ft. from N. Line

330 Ft. from S. Line330 Ft. from E. Line

_____ Ft. from W. Line

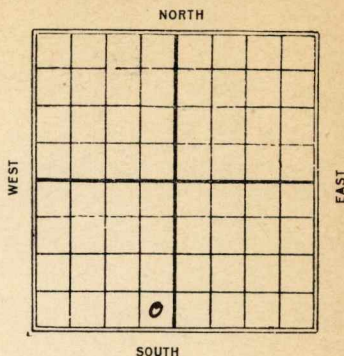1927

Date

REPORT

2/24	R O. G.
3/2	—
3/9	Rig
3/16	—
3/24	Spudg 750
3/30	Drilg 600
4/7	" 810
4/13	" 1000
4/20	" 1490
4/27	" 1900
5/5	" 2250
5/12	" 2800
5/25	Abandoned 3089

11 **KANSAS** Sec. 3 Twp. 28 R. 6

Well No. 6 *Blakeman*
Mid-Kansas Company

Contractor

FIRST REPORTS

_____ Ft. from N. Line

330 _____ Ft. from S. Line

330 _____ Ft. from E. Line

_____ Ft. from W. Line

SECTION PLAT

Location _____

Rig up _____

Drilling and Remarks:

No. 5.

RECORD

Cased _____ in., _____ ft.

Sand _____

Gas _____

Oil _____

Total Depth _____

PRODUCTION

1st 24 hrs. Nat. _____

1st 24 hrs. after shot _____

Gas _____ Cu. Ft.

Dry Hole _____

Abandoned _____

Date

FEB 24 1927

CHAS. L. SHERWOOD

192

Scout

Butter

11 **KANSAS** 3 Twp. 28 R. 6
Map No. Sec. Twp. R.Well No. 6 Blackman
Mid-Kansas Company

Contractor

COMPLETED**SECTION PLAT**

Ft. from N. Line

330 Ft. from S. Line

330 Ft. from E. Line

Ft. from W. Line

ABANDONED

Location

Rig up

Drilling and Remarks:

top line 2800'

low oil 2052-58'

PAFW.

DQ # 3089

RECORD

Cased _____ in., _____ ft.

Sand _____

Gas _____

Oil _____

Total Depth 3089'

PRODUCTION

1st 24 hrs. Nat. _____

1st 24 hrs. after shot _____

Gas _____ Cu. Ft.

Dry Hole ✓

Abandoned ✓

Date

MAY 25 1927

CHAS. L. SHERWOOD

192

Scout