
Russel

Form 51—5M—3-35—Mid-West

Map No. KANSAS Sec. 32 Twp. 13 R. 14W

Well No. #1-P. Boxberger Farm

Empire oil. Company

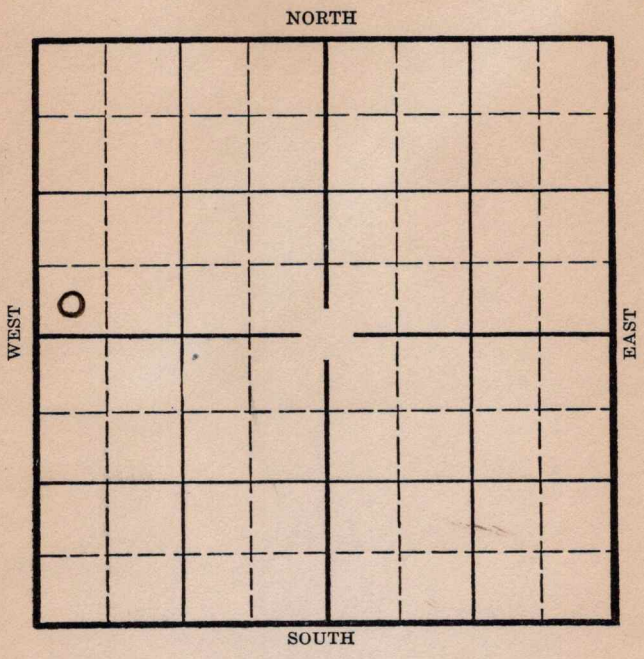

Location

Drilling Remarks

Rig Up

Drilling Remarks

RECORD

Cased in. ft.

Sand

Gas

Oil

Total Depth

PRODUCTION

1st 24 hrs. Nat.

1st 24 hrs. after shot

Gas cu. ft.

Dry Hole

Abandoned

Form 252-A
5M 7-35 MPC


KANSAS

RUSSELL

Map No. _____ Sec. 32 Twp. 13 R. 14-W

Well No. 1-P.Boxberger Farm

Empire Oil Company

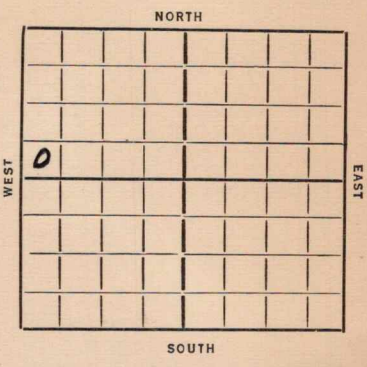

_____ Ft. from N. Line

330 Ft. from S. Line

_____ Ft. from E. Line

330 Ft. from W. Line

Elev. 1871

Date 1936	REPORT
4/1	Location
4/10	R.O.G.
4/16	Rig.
4/23	Drlg. ~~30~~ 390'
4/30	390' of 15". Drlg. 625'
5/7	Drlg. 1105'.
5/14	10" @ 2075'. Drlg.
5/21	Drlg. 2680'.
5/28	Oswald 3032'. '" @ 3035'. Drlg.3070
6/5	---SHUT DOWN—
6/11	3251' Under reaming ~~8~~6".
6/18	Sil. 3303' Oil. 3304'. T.D. 3312'.
	1350' oil in 8 hours.
6/25	No test.
7/2--7/9--	
7/15/36	-Sil. 3303'.
	T.D. 3312'.
	1000 gallons of acid.
	446 bbls of oil potential

COMPLETED

Form 26—1M Bks—9-28 Revised

KANSAS

Map No. 72 Sec. 32 Twp. 13 R. 14W


Well No. 1-P. Boxberger

Empire Oil Company

Contractor

FIRST REPORTS

SECTION PLAT

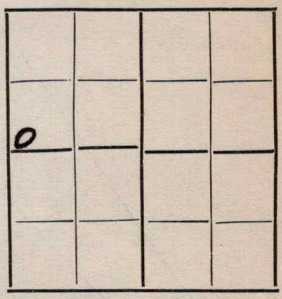

330 Ft. from N. Line

330 Ft. from S. Line

Ft. from E. Line

330 Ft. from W. Line

Location 1

Rig up

Drilling and Remarks:

RECORD

Cased in., ft.

Sand

Gas

Oil

Total Depth

PRODUCTION

1st 24 hrs. Nat.

1st 24 hrs. after shot

Gas Cu. Ft.

Dry Hole

Abandoned

Date 4-1-36 192

ORVAL MANNSCHRECK Scout

Form 26—1M Bks.—2-29

KANSAS

Russell


Map No. 72 Sec. 32 Twp. 13 R. 14W

Well No. 1 P. Bontrager

Empire Company

Contractor

SECTION PLAT

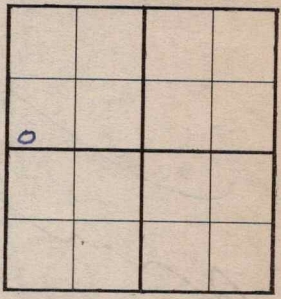

330 Ft. from N. Line

330 Ft. from S. Line

Ft. from E. Line

330 Ft. from W. Line

COMPLETED

Location

Rig up

Drilling and Remarks:

S. C. 3303

1000 Qual

P. T. 446.

RECORD

Cased in., ft.

Sand

Gas

Oil

Total Depth 3312

PRODUCTION

1st 24 hrs. Nat.

1st 24 hrs. after shot

Gas Cu. Ft.

Dry Hole

Abandoned

Date

JUL 15 1936 19

S. J. LEWIS Scout