


Section 32 Township 13 Range 14-W

Well No. #2 Peter Boxberger (A)

Company Cities Service Oil

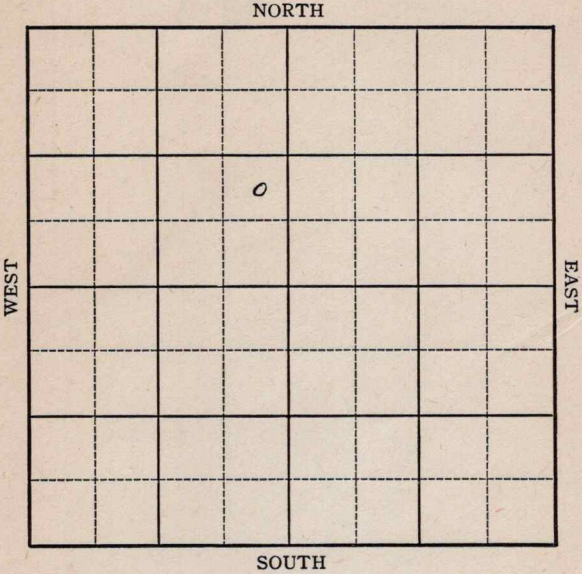

Sec. 32 Twp. 13 R. 14-W

Well No. #2 Peter Boxberger Farm

Cities Service Oil Company


_____ Ft. from N. Line

990 Ft. from S. Line

330 Ft. from E. Line

_____ Ft. from W. Line

Elev. 1869

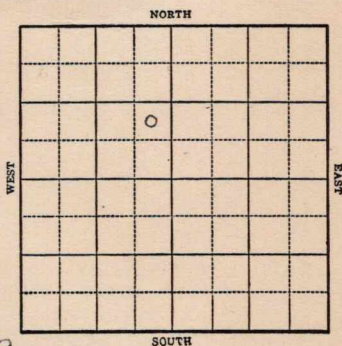

1944

R E P O R T

1-12 Moving in material

1/19 8" @ 344
Anhy 891
Drlg. 1440'

1/26 Drlg. 2900'

2/2 **Lans 3031**
Arb 3302-03 TD
4" @ 3303
Rust

2/8 "

2/15 "

2/23 "

3/1 **Arb 3297 Corrected**
4" @ 3298
TD 3309'
1000 acid
Pump 10 oil per hr.

3/8 " " "

3/16 " " "

3/22 " "

3/29 " "

4/5 4" @ 3298
Arb 3297
TD 3309
1000 acid Pump 250 Pot
Gravity 33

COMPLETED

KANSAS
Map No. 72 Sec. 32 Twp. 13 R. 14W

Well No. 2 Peter Boxberger

Cities Service Oil Company

FIRST REPORT Contractor

NE SE NW

SECTION PLAT

_____ Ft. from N. Line

990 Ft. from S. Line

330 Ft. from E. Line

_____ Ft. from W. Line

	o		

Russell Pool

Location _____

Rig up _____

Drilling and Remarks:

Moving in
material

RECORD

Cased _____ in., _____ ft.

Sand _____

Gas _____

Oil _____

Total Depth _____

PRODUCTION

1st 24 hrs. Nat. _____

1st 24 hrs. after shot _____

Gas _____ Cu. Ft.

Dry Hole _____

Abandoned _____

Date

JAN 12 1944 19

S. J. LEWIS Scout

KANSAS

Map No. 72 Sec. 32 Twp. 13 R. 14W

Well No. 2 Peter Boxberger

Cities Service Oil Company

COMPLETED Contractor

NE SE NW

SECTION PLAT

		6	

_____ Ft. from N. Line

990 Ft. from S. Line

330 Ft. from E. Line

_____ Ft. from W. Line

Russell Pool

Location _____

Rig up _____

Drilling and Remarks:

Core 3297
4 "C 3298
1000 acid
Pump 250 R/L

330 Gr

RECORD

Cased _____ in., _____ ft.

Sand _____

Gas _____

Oil _____

Total Depth 3309

PRODUCTION

1st 24 hrs. Nat. _____

1st 24 hrs. after shot _____

Gas _____ Cu. Ft.

Dry Hole _____

Abandoned _____

Date

APR 5 1944 19

S. J. LEWIS Scout