


Map No. Ks Sec. 30 Twp. 31 R. 11E

Well No. Farm
Guffy & Gillispie Company

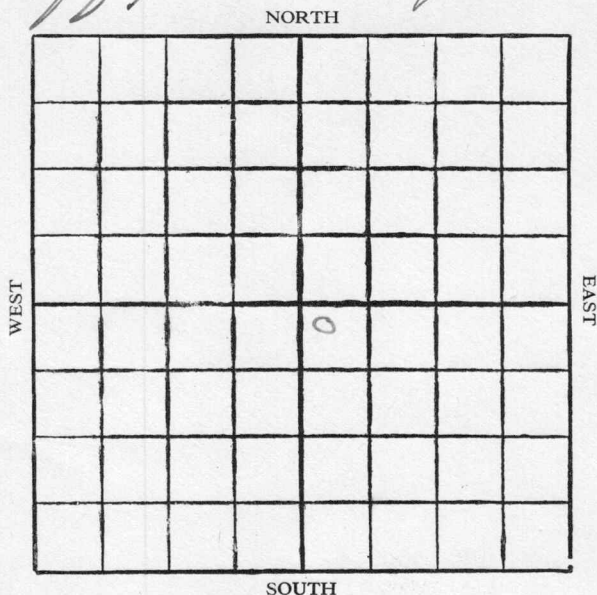

Location

Drilling Remarks

Rig Up

Drilling Remarks

.....

.....

RECORD

PRODUCTION

Cased in. ft.

Sand

Gas

Oil

Total Depth

1st 24 hrs. Nat.

1st 24 hrs. after shot

Gas cu. ft.

Dry Hole

Abandoned

4 KANSAS 30 Elk 31 11 W
 Map No. _____ Sec. _____ Twp. _____ R. _____

Well No. 1 _____

Guffy & Sullivan Company

Contractor _____

FIRST REPORTS

250 Ft. from N. Line

_____ Ft. from S. Line

_____ Ft. from E. Line

250 Ft. from W. Line

COMPLETED

SECTION PLAT

		ABANDONED	
		0	

Location _____

Rig up _____

Drilling and Remarks:

RECORD

Cased _____ in., _____ ft.

Sand _____

Gas _____

Oil _____

Total Depth 24.17

PRODUCTION

1st 24 hrs. Nat. _____

1st 24 hrs. after shot _____

Gas _____ Cu. Ft.

Dry Hole ✓

Abandoned ✓

Date

JAN 8 1927

CHAS. L. SHERWOOD

192 _____ Scout