


Butler
Map No. Kansas Sec. 9 Twp. 28 R. 6
Well No. 7 Blakemar Farm
Tom C Johnson Company
NORTH

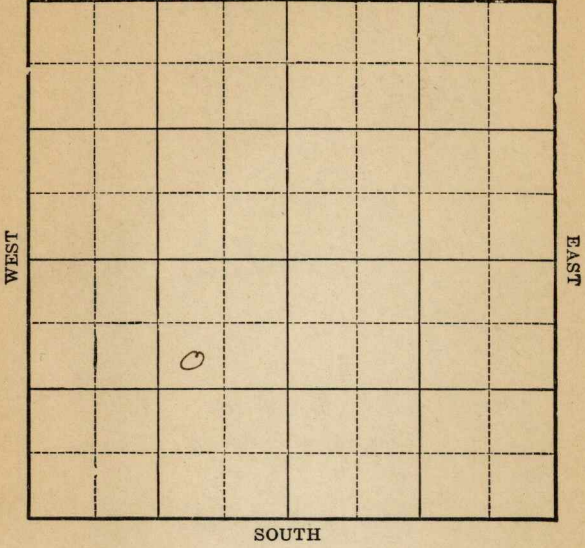

Location _____
Drilling Remarks _____

Rig Up _____
Drilling Remarks _____

RECORD

PRODUCTION

Cased _____ in. _____ ft.
Sand _____
Gas _____
Oil _____
Total Depth _____

1st 24 hrs. Nat. _____
1st 24 hrs. after shot _____
Gas _____ cu. ft.
Dry Hole _____
Abandoned _____

Butler

Map No. MAN Sec. 3 Twp. 28 R. 6


Well No. 7 Blakeman Farm
Tom C Johnson Company

990 Ft. from N. Line

..... Ft. from S. Line

990 Ft. from E. Line

..... Ft. from W. Line

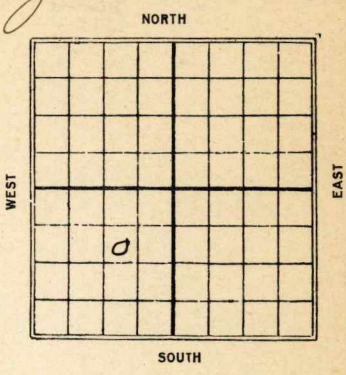

1926

Date	REPORT
------	--------

8/4	Bldg rig
8/11	rigging up
8/18	Dlg 440
8/25	Drlg 910
8/31	" 1710
9/15	top line 2773' show
9/22	Oil at 2747' Dlg 2800
9/22	Sand 3036-38'
9/29	200ft of oil in hole
9/29	Siliceous lime 3034-41
	Top line 2773
	400 bbls natural

Map No. 11 **KANSAS** Sec. 3 Twp. 28 R. 6

Well No. 7 *Blakeman*
John C. Johnson Company

Contractor

FIRST REPORTS

SECTION PLAT

990 Ft. from N. Line

_____ Ft. from S. Line

990 Ft. from E. Line

_____ Ft. from W. Line

	o		

Location _____

Rig up _____

Drilling and Remarks:

Blay Rig

RECORD

Cased _____ in., _____ ft.

Sand _____

Gas _____

Oil _____

Total Depth _____

PRODUCTION

1st 24 hrs. Nat. _____

1st 24 hrs. after shot _____

Gas _____ Cu. Ft.

Dry Hole _____

Abandoned _____

Date

AUG 4 1926

192

CHAS. L. SHERWOOD

Scout

Butler

Map No. 11 **KANSAS** Sec. 3 Twp. 28 R. 6

Well No. 7 *Blakeman*

Sam. C. Johnson Company

Contractor

COMPLETED

SECTION PLAT

990

Ft. from N. Line

Ft. from S. Line

990

Ft. from E. Line

Ft. from W. Line

Location *Blakeman*

Rig up

Drilling and Remarks:

Top line 2773

400 lbs natural

RECORD

Cased _____ in. _____ ft.

Sand *3034-3041*

Gas _____

Oil _____

Total Depth *3041*

PRODUCTION

1st 24 hrs. Nat. _____

1st 24 hrs. after shot _____

Gas _____ Cu. Ft.

Dry Hole _____

Abandoned _____

Date

SEP 29 1926

CHAS. L. SHERWOOD

192

Scout