


Section 32 Township 18 Range 10 WWell No. # 1 RingwaldCompany L. D. Sargent

NORTH

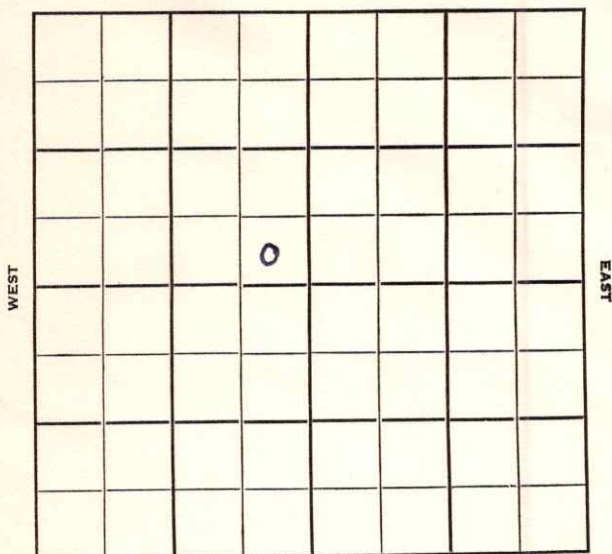

SOUTH

Rice **KANSAS** ✓

Sec. 32 Twp. 18 R. 10 W

Well No. # 1 Ringwald Farm

L. D. Sargent Company


Fleming & Woodman Contractor

 Ft. from N. Line

330 Ft. from S. Line

330 Ft. from E. Line

 Ft. from W. Line

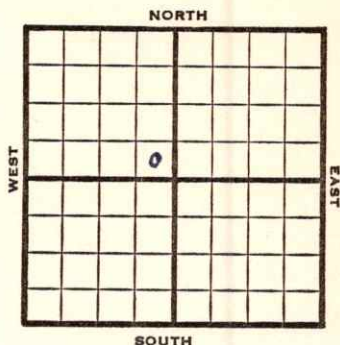

SE SE NW

1952

Elev. 1743' REPORT

6/4 Spud 5-31-52
8" @ 276' **Anhy 457'**
Drlg. 1775'

6/11 **Lans. 2903'** RTD 3185' 5" @ 3184'

6/18 CO 3185 NS DD @ 3186

6/25 DD 3209' 1 Qt OPH To hyd.

7/2 Hyd B/4 BOPH DD 3211 30 qts

7/9 CO NS PB 3120 26/3067-72
500 A Broke pipe CO

7/17 Tub & Rods

7/23 500 A S/ 8 galoph PB 3060
26/3036-42 S./6 galoph 500 A
F 18 Boph S/ 5 Boph 200 A S&F
18 Boph & SSW for 10 hrs. POP

7/30 NR

8/6 "

8/13 "

8/20 "

8/27 "

9/4 Spud 5-31-52 Oil Well TD 3211
8" @ 276 **Anhy 457 Lans. 2903**
DST 2989-94 open 3/4 hr. rec. 10' mud
DST 2989-3004 open 1 hr. rec. 18' mud
DST 3039-47 open 3/4 hr. rec. 90'
o & gcm 1100# TD 3185 5" @ 3184
CO to 3185 DD 3186 DD 3209

OVER

1952

9/4

1 qt. oph Hydro. B/ $\frac{1}{4}$ boph
DD 3211 S/ 30 qt/ PB 3120
26/ 3067-72 500 A S/ 8 boph
PB 3060 26/ 3036-42 S/ 6 goph
500 A F/ 18 boph S/ 5 boph
2000 A S & F/ 18 boph & SSW
P/ 25 bopd 4% wtr.
Comp. 32 bopd 6% wtr.

COMPLETED

County **Rice** State **Kansas**Sec. **32** (Blk. Twp.) **18** (Sur. Rge.) **10W** Map No.Operator **L. D. Sargent**Well No. **1** Farm **Ringwald**Elev. Location **SE SE NW****330** Ft. From **S** Line **NW****330** Ft. From **E** Line **Quarter**1st. Report **JUN 4 1952**

Completion

Remarks


Fleming & Woodman • Contr.Spudding Date **5-31-52**

Drlg. Data

8" @ 276 Anyh 457 drlg. 1075

J. G. McGEHEE

County Rice State Kansas
 Sec. 32 (Blk.) 18 (Sur.) 10W Map No.
 Operator L. D. Sargent
 Well No. 1 Farm Ringwald
 Elev. 1743 Location SE SE NW

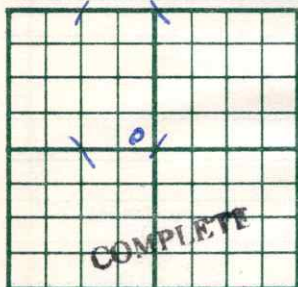

330 Ft. From S Line NW
330 Ft. From E Line Quarter

1st. Report

Completion SEP 4 1952

Remarks

Fleming & Woodman - Contr

Spudding Date 5-31-52

Drilg. Data Oil well TD 3211
8" @ 276 Anhy 457 Lans. 2903
DST 2989-94 open 3/4 hr. Rec. 10' mud
DST 2989-3004 open 1 hr. Rec. 18' mud
DST 3039-47 open 3/4 hr. Rec. 90' o &
gcm 1100# TD 3185 5" @ 3184
CO to 3185 DD 3186 DD 3209 1 qt. oph
Hydro. B/ 1/4 boph DD 3211 S/ 30 qt/
PB 3120 26/ 3067-72 500 A S/ 8 boph
PB 3060 26/ 3036-42 S/ 6 goph 500 A
F/ 18 boph S/ 5 boph 2000 A S & F/
18 boph & SSW P/ 25 bopd 4% wtr.
Comp. 32 bopd 6% wtr.