


Section 32 Township 18 Range 10W

Well No. #6 Ringwald

Company Anderson-Prichard

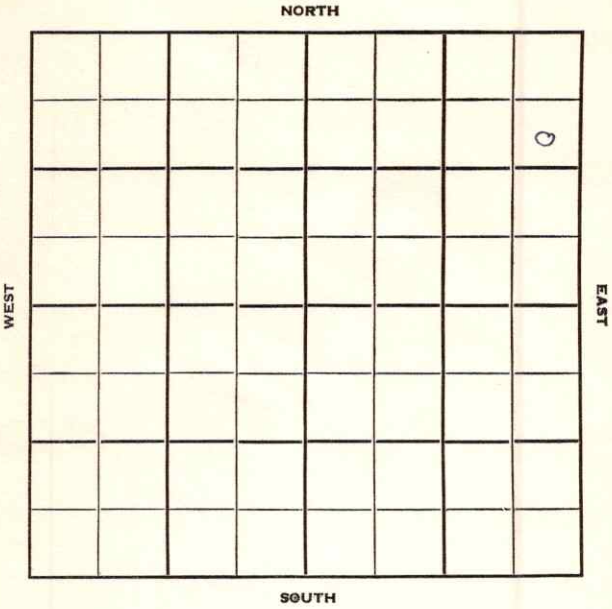

KANSAS

Rice

Sec. 32 Twp. 18 R. 10W

Well No. #6 Ringwald Farm

Anderson-Prichard Company

B & B Drlg. - Contr. Contractor

Ringwald


990' Ft. from N. Line

Ft. from S. Line

330' Ft. from E. Line

Ft. from W. Line

SE NE NE

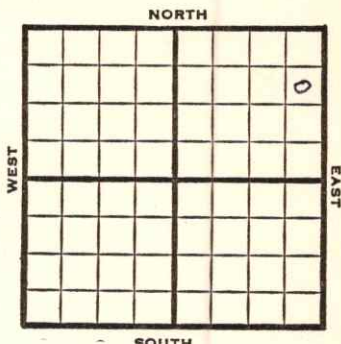

1952 **Elev. 1741'** REPORT

2/27 Spud 2-25-52
8" @ 260
WOC

3/5 Drlg. 2853'

3/11 Heeb. 2724 Br Li 2840
Lans. 2860

DST 2937-51, 1 hr. 580' gas cut oil
& wtr. 120' wtr. 435#

Cong. 3103 TD 3120 5" @ 3116'

3/19 TD 3126 Double Hyd S/126 BO 12 hrs.

4/2 Spud 2-25-52
Oil Well TD 3126
8" @ 260' Heeb. 2724
Br Li 2840 Lans. 2860
DST 2937-53 open 1 hr. rec. 580'
GCO & wtr. 120' wtr.
Cong. 3103 TD 3120 5" @ 3116
DD 3126 Hydro S/ 126 BO 12 hr.
Comp. 190 bopd

COMPLETED

County **Rice** State **Kansas**Sec. **32** (Blk. Twp.) **18** (Sur. Rge.) **10W** Map No.Operator **Anderson-Prichard**Well No. **6** Farm **Ringwald**Elev. Location **SE NE NE**

FIRST REPORT


990 Ft. From **N** Line **NE****330** Ft. From **E** Line Quarter1st. Report **FEB 27 1952**

Completion

Remarks

B & B Drlg. - Contr.Spudding Date **2-25-52**Drlg. Data **Ringwald****8" @ 260 W.O.C.****J. G. McGEHEE**

County Rice State Kansas
 Sec. 32 (Blk.) 18 (Sur.) 10W Map No.
 Operator Anderson-Prichard
 Well No. 6 Farm Ringwald
 Elev. 1741 Location SE NE NE

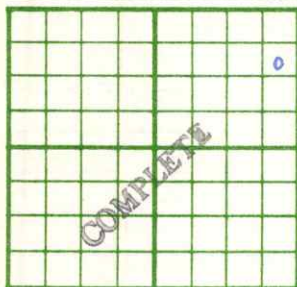

990 Ft. From N Line NE
330 Ft. From E Line Quarter

1st. Report

Completion APR 2 1952

Remarks Ringwald Pool
B & B Drlg. - Contr.

Spudding Date 2-25-52

Drlg. Data Oil well TD 3126

8" @ 260 Heeb. 2724 Br. lime 2840

Lens. 2860 DST 2937-53 open 1 hr.

Rec. 580' gco & water 120' water

Cong. 3103 TD 3120 5" @ 3116 DD 3126

Hydro. S/ 126 bo 12 hr.

Comp. 190 bopd

J. G. McGEHEE