Elk

KANSAS

SECTION 31 TOWNSHIP 31S RANGE 12E

WELL NO. #1 Persinger

COMPANY H & D

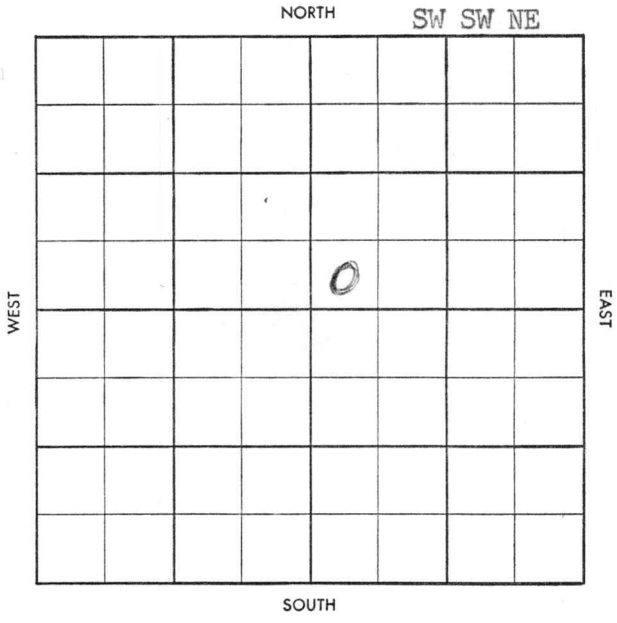

FORM 504-3 SUNRAY

WILDCAT

S—513-B

County Elk Elev.

Sec. 31 Twp. 31 Rge. 12E

Company H. & D.

Farm Name Persinger No. 1

TOPS	DEPTH	LOG	DATUM
Anh.			
Tp.			
H.			
Tr.			
Dg.			
B. L.			
L.			
K.C.			
B.K.C.			
Ce.			
C.			
M.			
M.			
K.			
Mz.			
Mq.			
V.			
S.			
S.			
A.			
R.			
Pf.			
G.			
T.D.			

Loc. in Sec. SW SW NE

Geol.

Contr.

Pool Wildcat

MAR 12 '56

FIRST REPORT

Date Comm. (Phillips - FO & DHM)

Location

Co. Lse. No. Sec. T. R.

Twp. Pool

Dk. Facet

S-513-B

County Elk Elev. 1045 DF

Sec. 31 Twp. 31 Rge. 12E

Company H. & D.

Farm Name Persinger No. 1

TOPS	DEPTH	LOG	DATUM
Anh Drum	818		
Tp. Lay	830	851	
H. Dem		921	
Tr. Lene		1191	
Dg. Altamont		1243	
B. L.			
L.			
K.C.			
B.K.C.			
Ce.	1455	1459	
C.			
M.	1738	1739	
M.			
K.			
Mz.			
Mq.			
V.			
S.			
S.			
A.	1998	1998	
R.			
Pf.			
G.			
T.D.	2065	2067	

Loc. in Sec. SW SW NE

Geol.

Contr.

Pool Wildcat

ABANDONED

APR 23 '58

Date Comm. 3-29-58 (Phillips - FO & DHM)

Location MAR 10 '58 MAR 28 '58 APR 2 '58 APR 9 '58

8"60' DST 1740-62 APR 15 '58

opn hr 45' M 30' VSO5pk M

FP 15-60 BHP 425 log

APR 23 '58

D&A

Co. Lse. No. Sec. T. R.