


Butler

Form 51-5M-3-26-22544

Map No. Trass 3 Sec. 3 Twp. 28 R. 6

Well No. 6 Blakeman Farm  
Tom C Johnson Company

NORTH

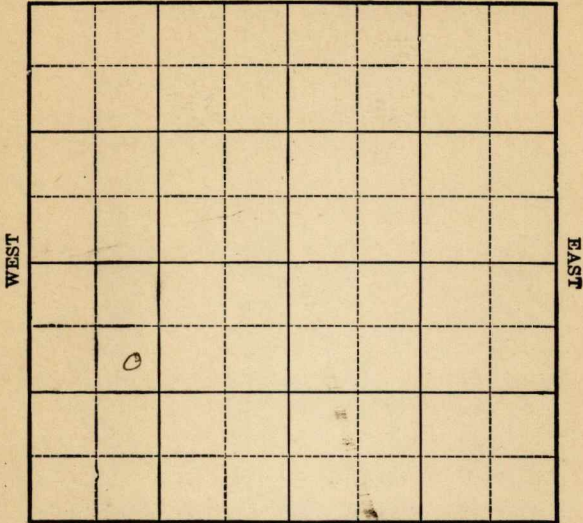

Location \_\_\_\_\_

Drilling Remarks \_\_\_\_\_  
\_\_\_\_\_  
\_\_\_\_\_  
Rig Up \_\_\_\_\_

Drilling Remarks \_\_\_\_\_  
\_\_\_\_\_  
\_\_\_\_\_  
**RECORD**

Cased \_\_\_\_\_ in. \_\_\_\_\_ ft.  
Sand \_\_\_\_\_  
Gas \_\_\_\_\_  
Oil \_\_\_\_\_  
Total Depth \_\_\_\_\_

**PRODUCTION**

1st 24 hrs. Nat. \_\_\_\_\_  
1st 24 hrs. after shot \_\_\_\_\_  
Gas \_\_\_\_\_ cu. ft.  
Dry Hole \_\_\_\_\_  
Abandoned \_\_\_\_\_

Butler

Map No. Kans Sec. 3 Twp. 28 R. 6


Well No. 6 Blakeman Farm  
Tom C. Johnson Company

990 Ft. from N. Line

..... Ft. from S. Line

..... Ft. from E. Line

990 Ft. from W. Line

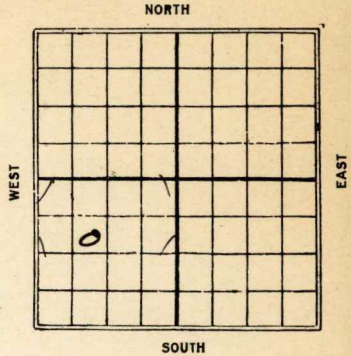

1926

Date REPORT

9/22	Bldg rig
9/29	Rigging up
10/3	Drlg 1300
10/27	fishing 1580'
11/4	Drlg 1965
11/7	Top line 2792-95'
	swabbing 30 bbls per hr.
11/23	"Correction" Sand S L M. Top line
	2771-74' Swabbing 10 BBls per hr
	Cutting 18% 38 Gravity
12/8	sd 3061-72' T D 3072'
	This well had a good
	producer in Top line 2792-95'
	but was drilled to Wilcox
	168 bbls Nat.

Butler

Map No. **11 KANSAS** Sec. **3** Twp. **28** R. **6**

Well No. **6 Blakemore**

**Tom. C. Johnson** Company

Contractor

**FIRST REPORTS**

**SECTION PLAT**

**990** Ft. from N. Line

----- Ft. from S. Line

----- Ft. from E. Line

**990** Ft. from W. Line


Location -----

Rig up -----

Drilling and Remarks:

*Blag Leg*

**RECORD**

Cased ----- in., ----- ft.

Sand -----

Gas -----

Oil -----

Total Depth -----

**PRODUCTION**

1st 24 hrs. Nat. -----

1st 24 hrs. after shot -----

Gas ----- Cu. Ft.

Dry Hole -----

Abandoned -----

Date

**SEP 22 1926**

192

**CHAS. L. SHERWOOD**

Scout

*Butter*

Map No. *11* **KANSAS** Sec. *3* Twp. *28* R. *6*

Well No. *6* *Blake man*  
*Tom C Johnson* Company

Contractor

**COMPLETED**

**SECTION PLAT**

*990* Ft. from N. Line  
Ft. from S. Line  
Ft. from E. Line  
*990* Ft. from W. Line


Location -----

Rig up -----

Drilling and Remarks:

*This well had  
& good production  
in Zap lino 2792-95  
But was drilled to  
wildcat.*

**RECORD**

Cased \_\_\_\_\_ in., \_\_\_\_\_ ft.  
Sand *3061-72*  
Gas \_\_\_\_\_  
Oil \_\_\_\_\_  
Total Depth *3072*

**PRODUCTION**

1st 24 hrs. Nat. \_\_\_\_\_  
1st 24 hrs. after shot \_\_\_\_\_  
Gas \_\_\_\_\_ Cu. Ft.  
Dry Hole \_\_\_\_\_  
Abandoned \_\_\_\_\_

*168 lbs nat.*

Date

**DEC 8 1926**

**CHAS. L. SHERWOOD**

192

Scout