


Sumner

KANSAS

Section 3 Township 32 Range 1E

Well No. #1 Harris

Company Wakefield

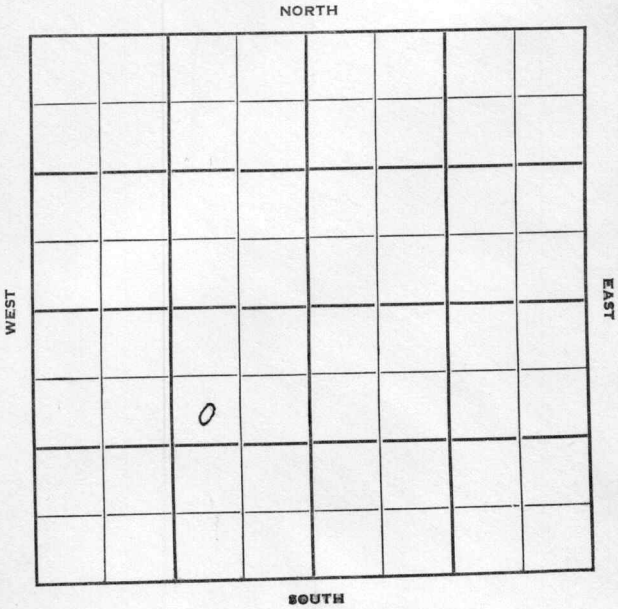

Sumner

KANSAS 1E ✓

Sec. 3 Twp. 32 R. 1E

Well No. #1 Harris Farm

Wakefield Company

Wildcat Contractor


990' Ft. from N. Line

 Ft. from S. Line

990' Ft. from E. Line

 Ft. from W. Line

SW NE SW

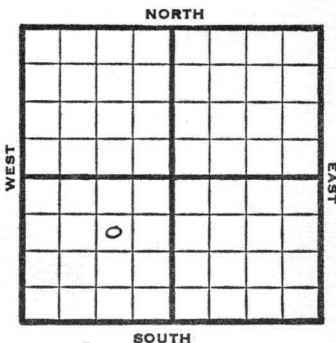

1950	Elev 1287 REPORT
5/3	8" @ 104' Dr1g. 1380'
5/24	TD 4080 8" @ 104 KC 3042 Miss 3571 Simp 4041-80 NS D&A ABANDONED

Kansas

Map No. _____ Sec. 3 Twp. 32 R. 1EWell No. 1 HarrisWakefield

Company _____

Contractor _____

SW NE SW

E1.1287

SECTION PLAT

990 Ft. from N. Line

_____ Ft. from S. Line

990 Ft. from E. Line

_____ Ft. from W. Line

Sumner

Location _____

Rig up _____

Drilling and Remarks:

8" C 104K.C. 3042Misc. 3571Simp. 4041-80NS D+A

RECORD

Cased _____ in., _____ ft.

Sand _____

Gas _____

Oil _____

Total Depth 4080

PRODUCTION

1st 24 hrs. Nat. _____

1st 24 hrs. after shot _____

Gas _____ Cu. Ft.

Dry Hole _____

Abandoned _____

Date

MAY 24 1950 19J. E. TYRA

Scout

Kansas

Map No. _____ Sec. 3 Twp. 32 R. 1EWell No. 1 HarrisWakefield Company

Contractor

SW NE SW

SECTION PLAT

990 Ft. from N. Line

_____ Ft. from S. Line

990 Ft. from E. Line

_____ Ft. from W. Line

Sumner County



Location _____

Rig up _____

Drilling and Remarks:

8" @ 104

drlg. 1380

RECORD

Cased _____ in., _____ ft.

Sand _____

Gas _____

Oil _____

Total Depth _____

PRODUCTION

1st 24 hrs. Nat. _____

1st 24 hrs. after shot _____

Gas _____ Cu. Ft.

Dry Hole _____

Abandoned _____

Date

MAY 3 1950

19

J. E. TYRA

Scout