


Map No. Kansas Sec. 3 Twp. 28 R. 6 Butler

Well No. X Kramer Farm

Allison & Fitzwilliam Company

NORTH

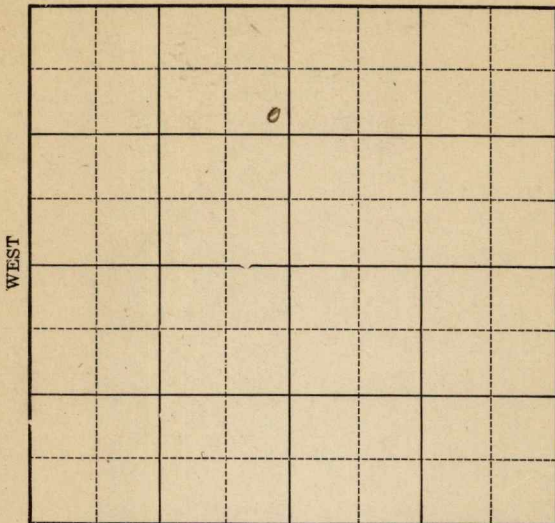

SOUTH

Location _____

Drilling Remarks _____

Rig Up _____

Drilling Remarks _____

RECORD

Cased _____ in. _____ ft.

Sand _____

Gas _____

Oil _____

Total Depth _____

PRODUCTION

1st 24 hrs. Nat. _____

1st 24 hrs. after shot _____

Gas _____ cu. ft.

Dry Hole _____

Abandoned _____

Butler

Map No. **K11 KANSAS** Sec. *3* Twp. *28* R. *6*

Well No. *1 Kramer*

Allison & Fitzwilliam Company

Contractor

FIRST REPORTS

SECTION PLAT

990 Ft. from N. Line

_____ Ft. from S. Line

330 Ft. from E. Line

_____ Ft. from W. Line

Location _____

Rig up _____

Drilling and Remarks:

Blow Rig

RECORD

Cased _____ in., _____ ft.

Sand _____

Gas _____

Oil _____

Total Depth _____

PRODUCTION

1st 24 hrs. Nat. _____

1st 24 hrs. after shot _____

Gas _____ Cu. Ft.

Dry Hole _____

Abandoned _____

Date

MAY 12 1926

192

CHAS. L. SHERWOOD

Scout

Bath Co

Map No. *111* **KANSAS** Sec. *3* Twp. *28* R. *6*

Well No. *2* *Kramer*

Whison & Fitzwilliams Company

Contractor

CORRECTION


SECTION PLAT

990 Ft. from N. Line

Ft. from S. Line

330 Ft. from E. Line

Ft. from W. Line

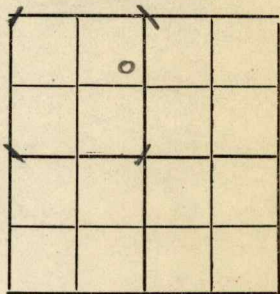

Location -----

Rig up -----

Drilling and Remarks:

*Previously reported
as #1. Chg to #2
and above. Name
name is correct.*

RECORD

Cased ----- in., ----- ft.

Sand -----

Gas -----

Oil -----

Total Depth -----

PRODUCTION

1st 24 hrs. Nat. -----

1st 24 hrs. after shot -----

Gas ----- Cu. Ft.

Dry Hole -----

Abandoned -----

Date

JUN 30 1926

CHAS. L. SHERWOOD

Scout

Map No. K11 KANSAS Sec. 3 Twp. 28 R. 6

Well No. 2 Granor

Alison & Fitzwilliam Company

Contractor

COMPLETED


990 Ft. from N. Line

Ft. from S. Line

330 Ft. from E. Line

Ft. from W. Line

SECTION PLAT

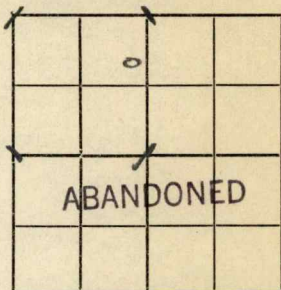

formerly carried as #1.

Location

Rig up

Drilling and Remarks:

*Tap lino 2800,
Wilcox 3120-25
AFW
J Q G
3145'*

RECORD

Cased _____ in., _____ ft.

Sand _____

Gas _____

Oil _____

Total Depth 3145

PRODUCTION

1st 24 hrs. Nat. _____

1st 24 hrs. after shot _____

Gas _____ Cu. Ft.

Dry Hole

Abandoned

Date

JUN 30 1926

CHAS. L. SHERWOOD

192

Scout