

Section 30 Township 18 Range 10 WWell No. # 1 SchmidtCompany Imperial Pet.

NORTH

0							

WEST

EAST

SOUTH

Rice

KANSAS

Sec. 30 Twp. 18 R. 10 W

Well No. # 1 Schmidt Farm

~~XXX~~ Imperial Pet. Company

B & B Contractor

Mary Ida Pool


Ft. from N. Line

990 Ft. from S. Line

Ft. from E. Line

330 Ft. from W. Line

NW SW SW

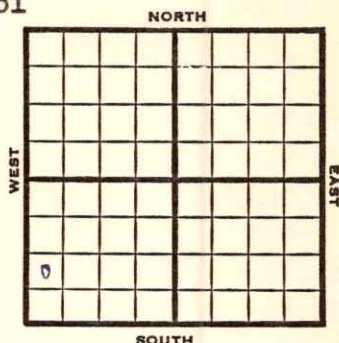


1951 Elev. 1756' REPORT

7/11 Spud 7-3-51
8" @ 286
Drilling 2880'

8/8 Spud 7-3-51
D&A TD 3340
8" @ 286 Heeb. 2843
Br Lime 2959 Lans. 2977
DST 3048-55 opn 1 hr
Rec. 15' mud DST 3059-69
opn 1/2 hr
Rec. 120' ho & gcm
DST 3140-57 opn 1 hr
Rec. 35' so & gcm
Cong. 3284 Arb. 3335
TD 3340 5" @ 3340
24/3314-18 500 A FU 150' wtr &
1 go PB 3186 18/3063-66
500 A FU 150' oil 1000 A
S/1 boph 15 bw 18/3074-77
6/3062-63 18/3063-64 1 go 3 gsw
wtr inc. D&A

ABANDONED

County **Rice** State **Kansas**
 Sec. **30** (Blk.) **18** (Sur.) **10W** Map No.
 Operator **Imperial Pet.**
 Well No. **1** Farm **Schmidt**
 Elev. **1756** Location **NW SW SW**

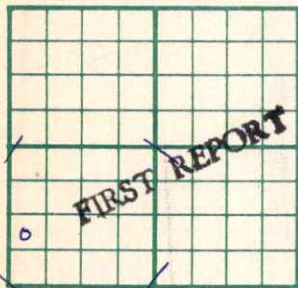

990 Ft. From **S** Line **SW**
330 Ft. From **W** Line **Quarter**

1st. Report **JUL 11 1951**

Completion

Remarks

B&B - Contractor

Spudding Date **7-3-51**

Drlg. Data

Mary Ida - pool

8" @ 286 Drlg. 2880

J. E. TYRA

County Rice State Kansas
 Sec. 30 (Blk. 18) (Sur. 10W) (Rge.) Map No.
 Operator Imperial Pet.
 Well No. 1 Farm Schmidt
 Elev. 1756 Location NW SW SW



990 Ft. From S Line SW
330 Ft. From W Line Quarter
 Ist. Report
 Completion 106 8 1951
 Remarks Mary Ida Pool
B & B Drlg. - Contr.
 Spudding Date 7-3-51

Drlg. Data D & A TD 3340

8" @ 286 Heeb. 2843 Br. lime 2959

Lans. 2977 DST 3048-55 open 1 hr.

Rec. 15' mud DST 3059-69 open $\frac{1}{2}$ hr.

Rec. 120' ho & gcm DST 3140-57

open 1 hr. Rec. 35' so & gcm Cong. 3284

Arb. 3335 TD 3340 5" @ 3340

24/ 3314-18 500 A FU 150' water & 1 go

PB 3186 18/ 3063-66 500 A FU 150' oil

1000 A S/ 1 boph 15 bw 18/ 3074-77

6/ 3062-63 18/ 3063-64 1 go 3 gsw

water inc. D & A

J. E. TYRA