


Section 32 Township 18 Range 10 WWell No. # 7 RingwaldCompany Anderson-Prichard

NORTH

WEST

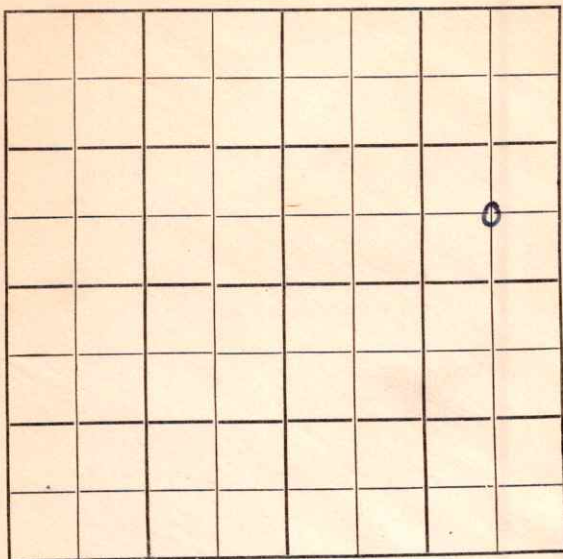

EAST

SOUTH

Sec. 32 Twp. 18 R. 10W

Well No. #7 Ringwald Farm

Anderson-Prichard Company

Peel
Ringwald Contractor


Ft. from N. Line

660 Ft. from S. Line

660 Ft. from E. Line

Ft. from W. Line

C SE NE

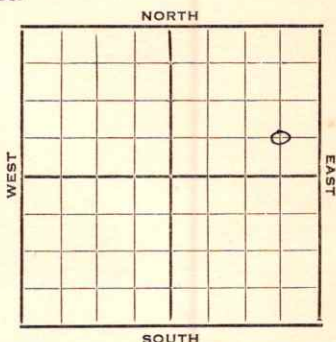

1952

Elev. 1741

REPORT

5/21

MI

5/28

8" @ 258'

DST 2681-89' 1 hr. 30' OCM

Drlg. ahead

6/11

Topeka 2414' Heeb 2728' Br li 2843'
Lans. 2867'

DST 2950-63, 1 hr, 180' MCO

RTD 3096' 5" @ 3094 DD @ 3123'

6/18

Drlg. 3150'

6/25

TD 3142' 123/3112-42'

7/2

DD 3147 DD 3148 NS 20 qt nitro

3138-48 CO DD 3150 NS DD 3158 SSO

DD 3165 No help DD 3171 Hyd

7/9

B/1 1/4 BOPH PB 3020 60/2946-64

26/2946-64 3/4 BO & 1/4 BW

500 A S/77 BO 2 hrs.

F 69 BO 12 hrs. 16/64" ck.

OVER

1952

7/16

Spud 5-21-52

Oil Well TD 3171

8" @ 258 DST 2681-89 opn 1 hr.

Rec. 30' ocm **Top 2414 Heeb. 2728**

Br Lime 2843 Lans. 2867

DST 2950-63 opn 1 hr. Rec. 180'

gmco 270# TD 3096

5" @ 3094 DD 3123 DD 3142

123/3112-42 DD 3147 DD 3148

20 qt/3138-48 DD 3150 DD 3158

DD 3165 DD 3171 Hydro B/1 $\frac{1}{4}$ boph

PB 3020 60/2946-64 B/1 $\frac{1}{4}$ bo $\frac{1}{4}$ bw

3 hr. 26/2946-64 B/3/4 bo $\frac{1}{4}$ bw


1 hr. 500 A S/77 bo 2 hrs.

F/69 bo 12 hr. F/113 bo 24 hrs.

Comp. 112 bopd

COMPLETED

County Rice State Kansas
 Sec. 32 (Blk. 18 (Sur. 10W Map No.
 (Twp.) (Rge.)
 Operator Anderson - Prichard
 Well No. 7 Farm Ringwald
 Elev. Location C SE NE

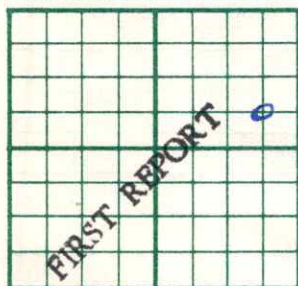

660 Ft. From S Line NE

660 Ft. From E Line Quarter

1st. Report MAY 21 1952

Completion

Remarks

Peel - Contr.


Spudding Date

Drlg. Data Ringwald

MI

J. G. McGEHEE

County Rice State Kansas
 Sec. 32 (Bk.) 18 (Sur.) 10W Map No.
 Operator Anderson-Prichard
 Well No. 7 Farm Ringwald
 Elev. 1741 Location C SE NE

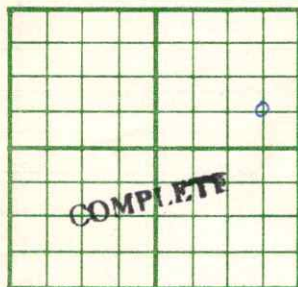

660 Ft. From S Line NE
 660 Ft. From E Line Quarter
 1st. Report
 Completion JUL 16 1952
 Remarks Ringwald Pool
Peel - Contr.
 Spudding Date 5-21-52

Drlg. Data Oil well TD 3171
8" @ 258 DST 2681-89 open 1 hr.
Rec. 30' oam Top. 2414 Heeb. 2728
Br. lime 2843 Lans. 2867 DST 2950-63
open 1 hr. Rec. 180' gmco 270#
TD 3096 5" @ 3094 DD 3123 DD 3142
123/ 3112-42 DD 3147 DD 3148
20 qt/ 3138-48 DD 3150 DD 3158
DD 3165 DD 3171 Hydro. B/ $1\frac{1}{4}$ boph
PB 3020 60/ 2946-64 B/ $1\frac{1}{4}$ bo $\frac{1}{4}$ bw
3 hr. 26/ 2946-64 B/ $\frac{3}{4}$ bo $\frac{1}{4}$ bw
1 hr. 500 A S/ 77 bo 2 hr.
F/ 69 bo 12 hr. F/ 113 bo 24 hr.
Comp. 112 bopd

J. G. McGEHEE