


Kansas

Map No. _____ Sec. *3* Twp. *28* R. *6*

Well No. *1 - Gilson* _____ Farm

Mid-Kansas _____ Company

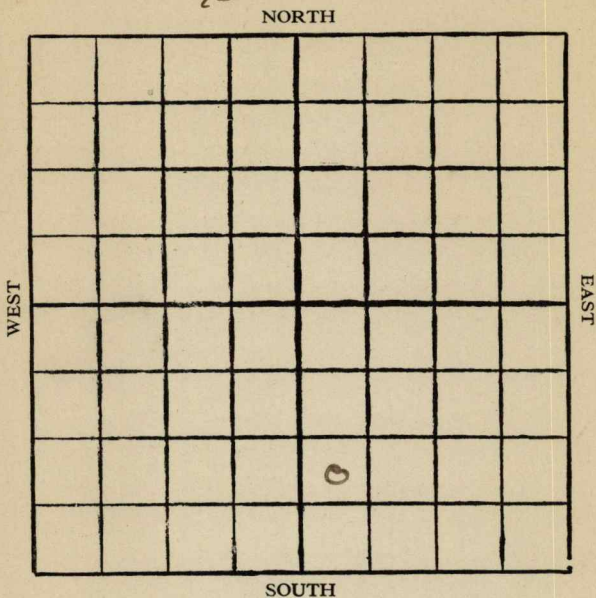

Location _____

Drilling Remarks _____

Rig Up _____

Drilling Remarks _____

RECORD

Cased _____ in. _____ ft.

Sand _____

Gas _____

Oil _____

Total Depth _____

PRODUCTION

1st 24 hrs. Nat. _____

1st 24 hrs. after shot _____

Gas _____ cu. ft.

Dry Hole _____

Abandoned _____

Kansas

Map No. Sec. 3 Twp. 28 R. 6

Well No. 1 - Gilson Farm
Mid-Kansas Company

Ft. from N. Line

990


Ft. from S. Line

Ft. from E. Line

Ft. from W. Line

330

1927

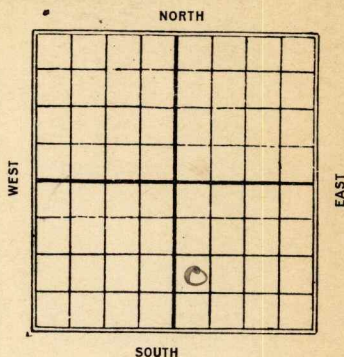

Date

REPORT

2/10 Bldg. Rig

2/17 Rig

2/24

3/2 Rigging up

3/9 Brelg 495

3/16 " 1100

3/24 " 1200

3/30 " 1600

4/7 " 2120

4/13 " 2350

4/20 " 2550

4/27 " 2850

5/5 Top line 2780-2950

top sand 3036-3042

36 bbls. 1st 24 hrs. will drill deeper.

5/11 Sand 3036-3059

Top line 2780 ft.

Base line 2950 ft.

Plugged Back to

3042 from 3059

35 bbls Oil.

11 **KANSAS** Sec. 3 Twp. 28 R. 6

Well No. 1 *Silson*

Mid-Kansas Company

Contractor


FIRST REPORTS

_____ Ft. from N. Line

990 _____ Ft. from S. Line

_____ Ft. from E. Line

330 _____ Ft. from W. Line

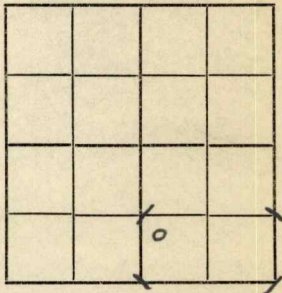SECTION PLAT

Location _____

Rig up _____

Drilling and Remarks:

Blog rig

RECORD

Cased _____ in., _____ ft.

Sand _____

Gas _____

Oil _____

Total Depth _____

PRODUCTION

1st 24 hrs. Nat. _____

1st 24 hrs. after shot _____

Gas _____ Cu. Ft.

Dry Hole _____

Abandoned _____

Date

FEB 10 1927

CHAS. L. SHERWOOD

192

Scout

11 **KANSAS** *Butter*
 Map No. _____ Sec. *3* Twp. *28* R. *6*

Well No. *1* *Silston*
Mid-Kansas _____ Company

 Contractor

COMPLETED

SECTION PLAT

_____ Ft. from N. Line

990 _____ Ft. from S. Line

_____ Ft. from E. Line

330 _____ Ft. from W. Line

		0	

Location _____

Rig up _____

Drilling and Remarks:

top lim 2780

base lim 2950

Plugged back to 3042

35 Bl.

RECORD

Cased *3036* in., *3059* ft.

Sand _____

Gas _____

Oil _____

Total Depth *3059*

PRODUCTION

1st 24 hrs. Nat. _____

1st 24 hrs. after shot _____

Gas _____ Cu. Ft.

Dry Hole _____

Abandoned _____

Date

MAY 1 1927

CHAS. L. SHERWOOD

192

Scout