


Section 31 Township 18 Range 10WWell No. #2 BuehlerCompany Sohio & Derby

NORTH

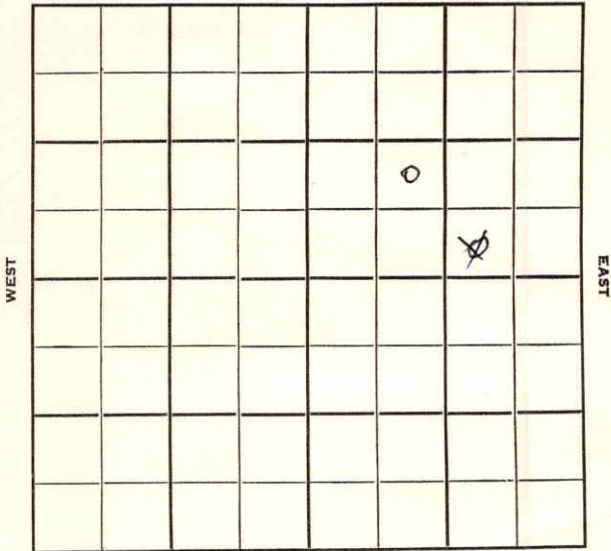

SOUTH

Rice

KANSAS

Sec. 31 Twp. 18 R. 10 W ✓

Well No. # 2 Buehler Farm

Sohio & Derby Company

Mary Ida Pool Contractor

Ft. from N. Line

990
330

Ft. from S. Line


990

Ft. from E. Line

990

Ft. from W. Line

~~SW SE NE~~
~~NE SW NE~~

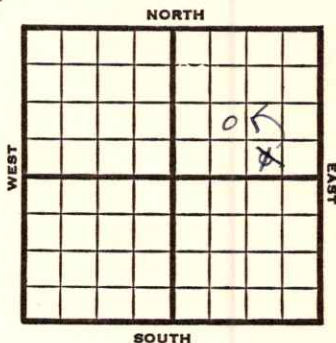

1951

Elev. 1740' REPORT

6/13

Location

9/19

Spud 6-15-41

Oil well TD 3291' 8" @ 312

Top. 2550'

DST 2736-74 open 1 hr. rec 150' mud

Br. line 2934' Lans. 2955'

DST 3041-51 open 1 hr. rec 55' mud & SSO

Arb. 3269-72 5" @ 3269' TD 3272'

$\frac{1}{2}$ GWPH DD 3277' 20 GOPH 500 A

S/ $\frac{1}{2}$ BOPH DD 3291' S/70 GO 4 GWPH

1000 A P/21 BO 18 BW 18 hr.

P/12 BO 16 BW 16 hr.

P/13 BO 13 BWPD

P/ 7 BO 13 BWPD

PB 3225' 24/3200-06 B/10 GO 4 GW

1000 A P/160 BO 20 hr.

Comp. 267 BOPD

COMPLETED

County **Rice** State **Kansas**Sec. **31** (Blk. **18** (Sur. **10W** Map No.Operator **Schio & Derby**Well No. **2** Farm **Buehler**Elev. Location **SW SE NE**

330 Ft. From **S** Line **NE****990** Ft. From **E** Line Quarter1st. Report **JUN 13 1951**

Completion

Remarks

Spudding Date

Drig. Data

Location **Mary Ida Pool**

Kansas

Map No. _____ Sec. 31 Twp. 18 R. LOWWell No. 2 Buehler_____Sohio & Derby Oil Company_____CORRECTION Contractor

NE SW NE

SECTION PLAT

_____Ft. from N. Line990 Ft. from S. Line_____Ft. from E. Line990 Ft. from W. Line

		0	

Rice County

Location _____

Rig up _____

Drilling and Remarks:

Reported

SW SE NE

RECORD

Cased _____ in., _____ ft.

Sand _____

Gas _____

Oil _____

Total Depth _____

PRODUCTION

1st 24 hrs. Nat. _____

1st 24 hrs. after shot _____

Gas _____ Cu. Ft.

Dry Hole _____


Abandoned _____

Date

JUL 2 1951 19J. E. TVPA

Scout

County Rice State Kansas
 Sec. 31 (Blk. 18) (Sur. 10W) Map No. 10W
 Operator Sohio & Derby
 Well No. 2 Farm Buehler
 Elev. 1740 Location NE SW NE

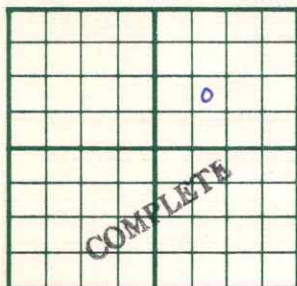

990 Ft. From S Line NE
 990 Ft. From W Line Quarter

1st. Report

Completion SEP 19 1951

Remarks Mary Ida Pool

Spudding Date 6-15-51

Drlg. Data Oil well TD 3291

8" @ 312 Top. 2550 DST 2736-74

open 1 hr. Rec. 150' mud Br. lime 2934

Lens. 2955 DST 3041-51 open 1 hr.

Rec. 55' mud & SSO Arb. 3269-72

5" @ 3269 TD 3272 $\frac{1}{2}$ gwph DD 3277

20 goph 500 A S/ $\frac{1}{2}$ boph DD 3291

S/ 70 go 4 gwph 1000 A P/ 21 bo

18 bw 18 hr. P/ 12 bo 16 bw 16 hr.

P/ 13 bo 13 bwpd P/ 7 bo 13 bwpd

PB 3225 24/ 3200-06 B/ 10 go 4 gw

1000 A P/ 160 bo 20 hr.

Comp. 267 bopd

J. E. TYRA