


Butler

Map No. Van Sec. 3 Twp. 28 R. 6

Well No. 4 Kramer Farm

Allison & Fitzwilliams Company

NORTH

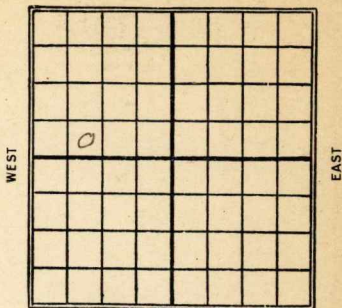

..... Ft. from N. Line

330 Ft. from S. Line

..... Ft. from E. Line

990 Ft. from W. Line

SOUTH

1926

Date

REPORT

9/11 R.O.G.

9/15 Drlg 500

9/22 " 1075

9/29 " 1850

10/13 Top line 2775'

Drlg 2860

10/27 Sand 3066-3072

topline 2775'

250 bbls natural

Butler

Map No. 11 **KANSAS** Sec. 3 Twp. 28 R. 6

Well No. 4 5 Glenn

Alison & Fitzwilliams Company

Contractor

FIRST REPORTS

SECTION PLAT

----- Ft. from N. Line

330 Ft. from S. Line

----- Ft. from E. Line

990 Ft. from W. Line

o			

Location -----

Rig up -----

Drilling and Remarks:

Rob

RECORD

Cased ----- in., ----- ft.

Sand -----

Gas -----

Oil -----

Total Depth -----

PRODUCTION

1st 24 hrs. Nat. -----

1st 24 hrs. after shot -----

Gas ----- Cu. Ft.

Dry Hole -----

Abandoned -----

Date

SEP 1 1926

192

CHAS. L. SHERWOOD

Scout

Butler

Map No. **11** **KANSAS** Sec. **3** Twp. **28** R. **6**

Well No. **4** **15 corner**

Allison & Fitzwilliams Company

Contractor

COMPLETED

SECTION PLAT

Ft. from N. Line

330

Ft. from S. Line

Ft. from E. Line

990

Ft. from W. Line

Location

Rig up

Drilling and Remarks:

Top line 2775'

750 lb. natural.

RECORD

Cased in, **3072** ft.

Sand **3066-3072**

Gas

Oil

Total Depth **3072**

PRODUCTION

1st 24 hrs. Nat. _____

1st 24 hrs. after shot _____

Gas _____ Cu. Ft.

Dry Hole _____

Abandoned _____

Date

OCT 27 1926

CHAS. L. SHERWOOD

192

Scout