

Section 29 Township 18 Range 10 W

Well No. # 2 Bieberle

Company Henderson Oil

NORTH

						0	

WEST

EAST

SOUTH

Sec. 29 Twp. 18 R. 10W

Well No. #2 Bieberle Farm

Henderson Oil Company

Carr Todd Contractor


330 Ft. from N. Line

..... Ft. from S. Line

990 Ft. from E. Line

..... Ft. from W. Line

NW NE NE

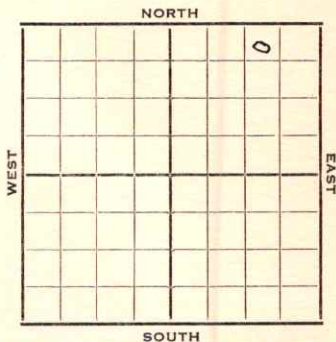

1952 **Elev. 1749'** REPORT

6/25 Spud 5-17-52
8" @ 247'
Anhy 490'
Drlg. 2774'

7/2 **Lans 2930**
DST 3060-80 1/2 hr. 4' M
DST 3108-25 1 hr. 30' SOCM
Cong. 3235 Arb. 3243
RTD 3255 5" @ 3246

7/9 DD 3278 500 A S/3 BOPH POP

7/16 Spud 6-17-52
Oil well TD 3278' 8" @ 247
Anhy 490' Lans. 2930'
DST 3060-80 open 1/2 hr. rec 4' mud
DST 3108-25 open 1 hr. rec 30' SOCM
Cong. 3235' Arb. 3243' TD 3255'
5" @ 3246 DD 3278 500 A S/3 BOPH
Comp. 85 BOPD 5% water.

COMPLETED

County Rice State Kansas
 Sec. 29 (Blk.) 18 (Sur.) 10W Map No. (Twp.) (Rge.)
 Operator Henderson Oil
 Well No. 2 Farm Bieberle
 Elev. 1749 Location NW NE NE

330 Ft. From N Line NE990 Ft. From E Line Quarter

1st. Report

Completion JUL 16 1952

Remarks

Carl Todd - Contr.Spudding Date 6-17-52

Drig. Data Oil well TD 3278
8" @ 247 Anhy 490 Lans. 2930
DST 3060-80 open $\frac{1}{2}$ hr. Rec. 4' mud
DST 3108-25 open 1 hr. Rec. 30' socm
Cong. 3235 Arb. 3243 TD 3255
5" @ 3246 DD 3278 500 A S/ 3 boph
Comp. 85 bopd 5% water

J. G. McGEHEE