


Section 1 Township 32 Range 2-E

Well Number #1 Hawkins


Company C. Davis et al

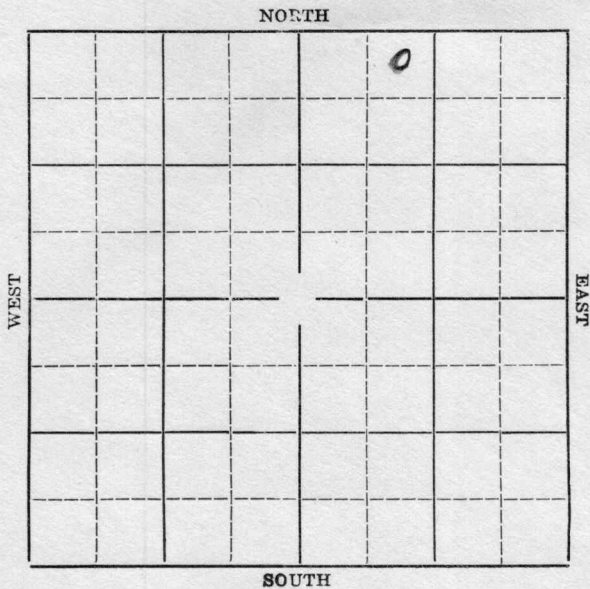

Well No. #1 Hawkins Farm
C. Davis et al Company

990' Ft. from W. Line

Elev. 1158

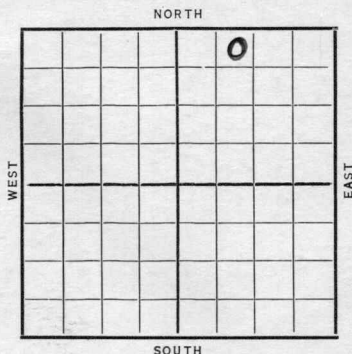

~~1936~~	REPORT
10/28	Machine.
11/6	Spud
11/12	15" @ 430 Clean out.
11/19	12" @ 925'. Drlg. 940'.
11/27	Drlg. 1520'.
12/3	1722' underream 10".
12/10	Drlg. 2075'.
12/17	8" @ 2125'. Drlg. 2375'.
12/24	Drlg. 2390'.
12/29	KCL 2462'. 6" @ 2471'. Drlg. 2575'.
1937	
1/7	Drlg. 3075'.
1/13	Sil. 3225'. T. D. 3256'. H. F. W. 3235'.
	<u>ABANDONED</u>

KANSAS

Map No. 1 Sec. 1 Twp. 32 R. 26Well No. 1 HawkinsC Davis & Co. Company

Contractor

SECTION PLAT

330 Ft. from N. Line

_____ Ft. from S. Line

_____ Ft. from E. Line

990 Ft. from W. Line

FIRST REPORT

Location _____

Rig up _____

Drilling and Remarks:

Mac H.

RECORD

Cased _____ in., _____ ft.

Sand _____

Gas _____

Oil _____

Total Depth _____

PRODUCTION

1st 24 hrs. Nat. _____

1st 24 hrs. after shot _____

Gas _____ Cu. Ft.

Dry Hole _____

Abandoned _____

Date

OCT 28 1936 19S. J. LEWIS Scout

KANSAS

Map No. 1 Sec. 1 Twp. 32 R. 2EWell No. 1 HawkinsC. Davis & Co.

Company

Contractor

SECTION PLAT

820 Ft. from N. Line

_____ Ft. from S. Line

_____ Ft. from E. Line

990 Ft. from W. Line

ABANDONED

		○	

Location _____

Rig up _____

Drilling and Remarks:

Si/3225AFW3235JYA

RECORD

Cased _____ in., _____ ft.

Sand _____

Gas _____

Oil _____

Total Depth 3256

PRODUCTION

1st 24 hrs. Nat. _____

1st 24 hrs. after shot _____

Gas _____ Cu. Ft.

Dry Hole _____

Abandoned _____

Date

JAN 13 1937

19

S. J. LEWIS

Scout