


Map No. KANSAS Sec. 1 Twp. 32 R. 2E
 Well No. Sheppard Farm
H. A. Cameron Company

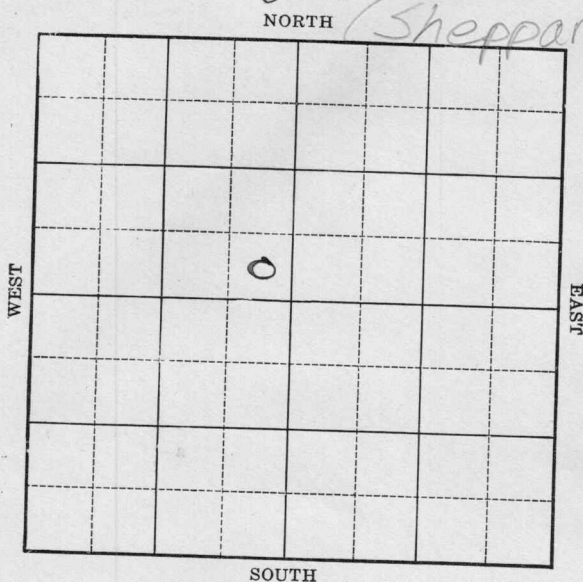

Location _____

Drilling Remarks _____

Rig Up _____

Drilling Remarks _____

RECORD

Cased _____ in. _____ ft.

Sand _____

Gas _____

Oil _____

Total Depth _____

PRODUCTION

1st 24 hrs. Nat. _____

1st 24 hrs. after shot _____

Gas _____ cu. ft.

Dry Hole _____

Abandoned _____

Map No. KANSAS Sec. 1 Twp. 32 R. 2 E
 Well No. 1 - Shepherd Farm
W.A. Cameron Company

NORTH

Ft. from N. Line

330 Ft. from S. Line330 Ft. from E. Line

Ft. from W. Line

WEST

EAST

SOUTH

1928

Date

REPORT

7/3	Rig in up
7/11	
7/18	Spud - S.D.
7/15	—
8/1	—
8/7	Drlg. 380
8/15	" 780
8/22	" 1020
9/5	" 1450
9/12	T.D. - 1810 fsg. tools
9/19	straighten & ream 8"
9/26	sand 1930 - 35' HFW
	T.D. 1935' U/R 8"
10/3	8" - 1960' Drlg 1970'
10/10	Drlg 2365'
10/17	" 2550'
10/24	2569' T.D. 2655'
	show oil & water.
10/31	No test
11/7	T.D. 2655 1/2'
	Dry & Abandoned

Sumner
 K1 KANSAS Map No. _____ Sec. 1 Twp. 32 R. 2E

Well No. 1 *Shepherd*

H. C. Cameron Company

Contractor

SECTION PLAT

_____ Ft. from N. Line

330 Ft. from S. Line

330 Ft. from E. Line

_____ Ft. from W. Line

FIRST REPORTS

Location _____

Rig up _____

Drilling and Remarks:

Rigging up

RECORD

Cased _____ in., _____ ft.

Sand _____

Gas _____

Oil _____

Total Depth _____

PRODUCTION

1st 24 hrs. Nat. _____

1st 24 hrs. after shot _____

Gas _____ Cu. Ft.

Dry Hole _____

Abandoned _____

Date

JUL 3 1928

S. J. LEWIS

Scout

MAP NO. K1 **KANSAS** SEC. 1 TWP. 32 R. 2E

WELL NO. 1 Shepherd

H. A. Cameron COMPANY

CONTRACTOR

SECTION PLAT

	0		

_____ FT. FROM N. LINE

330 FT. FROM S. LINE

330 FT. FROM E. LINE

_____ FT. FROM W. LINE

ABANDONED

RECORD

LOCATION _____

CASED _____ IN. _____ FT.

RIG UP _____

SAND _____

DRILLING AND REMARKS:

GAS _____

OH _____

TOTAL DEPTH 2655 1/2

IT & H

PRODUCTION

1ST 24 HRS. NAT. _____

1ST 24 HRS. AFTER SHOT _____

GAS _____ CU. FT.

DRY HOLE _____

ABANDONED _____

DATE

NOV 7 1928 192 S. J. LEWIS SCOUT