

KANSAS


Sumner county

FORM 51 5M 6-46 PETROL

Section 1 Township 32 Range 2-E

Well No. #1, Sheppard

Company Schneider & Campbell

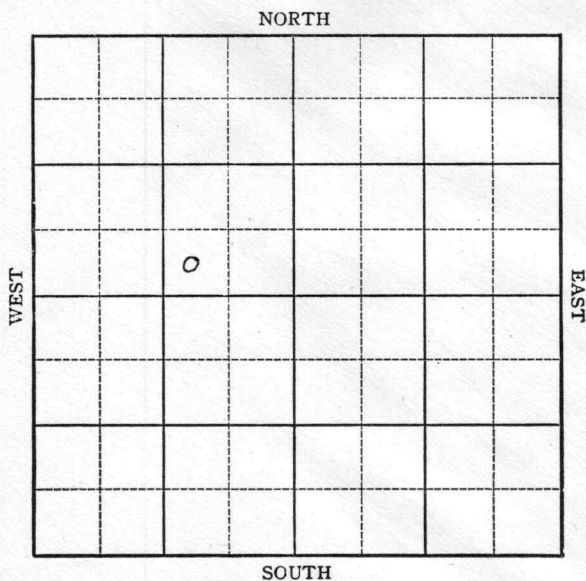


Sec. 1 Twp. 32 R. 2EWell No. #1 Sheppard FarmSchneider & Campbell Company

Miscellaneous

Ft. from N. Line

330 Ft. from S. Line990 Ft. from E. Line

Ft. from W. Line

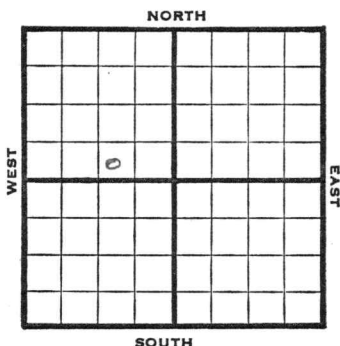

SW SE NW

1946

1191

REPORT

9/18 RUR
9/24 10" @ 97
Drlg 1335'
10/1 Stal 2198
Drlg 2384'
10/8 KC 2572
TD2591'
6" @ 2584 RUST
10/15 " "
10/22 " "
10/29 " "
11/6 Pump 7 oil plus 57 W in 12 hrs
11/13 KC 2572'
6" @ 2584'
TD 2667'

ABANDONED

KANSAS


Kansas Pool Name MiscellaneousMap No. 31 Sec. 1 Twp. 32 R. 2EWell No. 1 SheppardSchneider & Campbell

Company

FIRST REPORT

Contractor

SW SE NW

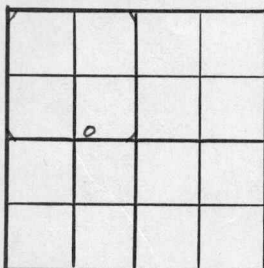SECTION PLAT Ft. from N. Line330 Ft. from S. Line990 Ft. from E. Line Ft. from W. LineSumner CountyLocation Rig up

Drilling and Remarks:

R U R

RECORDCased in., ft.Sand Gas Oil Total Depth **PRODUCTION**1st 24 hrs. Nat. 1st 24 hrs. after shot Gas Cu. Ft.Dry Hole Abandoned

Date

SEP 1 8 1946 19S. J. LEWIS

Scout

Map No. 1 Sec. 1 Twp. 32 R. 2E

Well No. 1 Sheppard

Schneider & Campbell Company

ABANDONED

Contractor

SW SE NW

E11191
SECTION PLAT

 Ft. from N. Line

330 Ft. from S. Line

990 Ft. from E. Line

 Ft. from W. Line

Sumner County

Location

Rig up

Drilling and Remarks:

KC 2572
6 02084

RECORD

Cased in., ft.

Sand

Gas

Oil

Total Depth 2667

PRODUCTION

1st 24 hrs. Nat.

1st 24 hrs. after shot

Gas Cu. Ft.

Dry Hole

Abandoned

Date

NOV 13 1946 19

S. J. LEWIS Scout