


Butler

Map No. *Kansas* Sec. *3* Twp. *28* R. *6*

Well No. *8 Kramer* Farm
Allison-Fitzwilliam Company

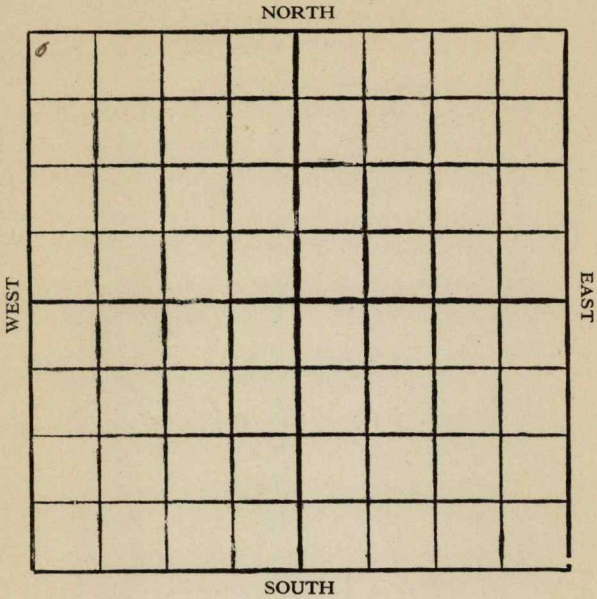

Location

Rig Up

Drilling Remarks

Drilling Remarks

.....

.....

RECORD

PRODUCTION

Cased in. ft.

Sand

Gas

Oil

Total Depth

1st 24 hrs. Nat.

1st 24 hrs. after shot

Gas cu. ft.

Dry Hole

Abandoned

Butler

Map No. Kansas Sec. 3 Twp. 28 R. 6

Well No. 8 Kramer Farm

Allison & Fitzwilliams Company


NORTH

330 Ft. from N. Line

..... Ft. from S. Line

..... Ft. from E. Line

330 Ft. from W. Line

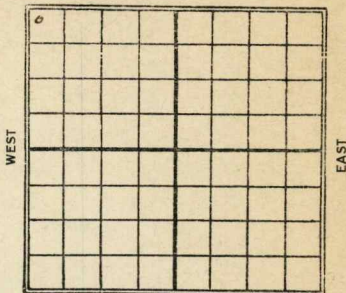

SOUTH

| Date | REPORT |
|------|--------------------|
| 1927 | |
| 5/18 | R.O.G. |
| 5/25 | Rig |
| 6/11 | Spudding |
| 6/7 | Dy 840 |
| 6/15 | " 1700 |
| 6/22 | " 2300 |
| 6/29 | " 2840 |
| 7/13 | 3084-3094 |
| | Top line 2765 |
| | 75 bbls T.D. 3094' |

check sec

Butler

11 **KANSAS** Sec. *3* Twp. *28* R. *6*

Well No. *8* *Walker*

Allison & Fitzwilliams Company

Contractor

FIRST REPORTS

SECTION PLAT

330 Ft. from N. Line
Ft. from S. Line
Ft. from E. Line
330 Ft. from W. Line

| | | | |
|---|--|--|--|
| 0 | | | |
| | | | |
| | | | |
| | | | |

Location _____
Rig up _____
Drilling and Remarks:

ROF

RECORD

Cased _____ in., _____ ft.
Sand _____
Gas _____
Oil _____
Total Depth _____

PRODUCTION

1st 24 hrs. Nat. _____
1st 24 hrs. after shot _____
Gas _____ Cu. Ft.
Dry Hole _____
Abandoned _____

Date

MAY 18 1927

CHAS. L. SHERWOOD

192 Scout

Butter

Map No. **11 KANSAS** Sec. *3* Twp. *28* R. *6*

Well No. *8* *Bannon*

Allison & Fitzwilliams Company

Contractor

COMPLETED

SECTION PLAT

330 Ft. from N. Line
Ft. from S. Line
Ft. from E. Line
330 Ft. from W. Line

| | | | |
|----------|--|--|--|
| <i>0</i> | | | |
| | | | |
| | | | |
| | | | |

Location

Rig up

Drilling and Remarks:

top line 2765

75 Bls

RECORD

Cased _____ in., _____ ft.
Sand *3084-3094*
Gas _____
Oil _____
Total Depth *3094*

PRODUCTION

1st 24 hrs. Nat. _____
1st 24 hrs. after shot _____
Gas _____ Cu. Ft.
Dry Hole _____
Abandoned _____

Date *July 13* 192*7*

CHAS. L. SHERWOOD

Scout