


Map No. K Sec. 9 Twp. 32 R. 1^E

Well No. 1 Harkins Farm
Waite Phillips Company

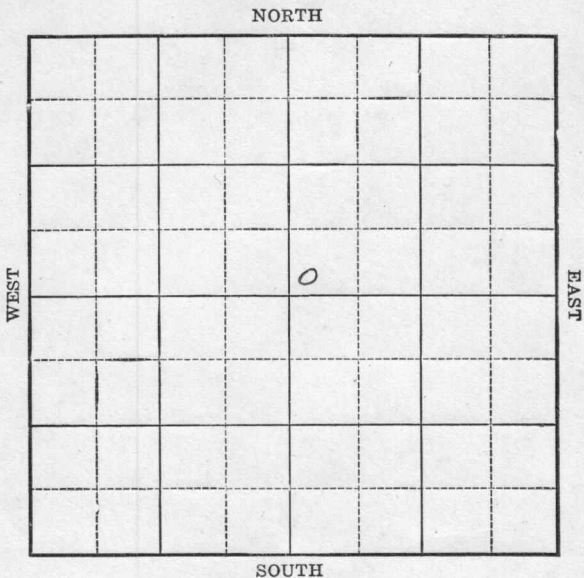

Location _____

Rig Up _____

Drilling Remarks:

Drilling Remarks:

RECORD

PRODUCTION

Cased _____ in. _____ ft.

1st 24 hrs. Nat. _____

Sand _____

1st 24 hrs. after shot _____

Gas _____

Gas _____ cu. ft.

Oil _____

Dry Hole _____

Total Depth _____

Abandoned _____

Map No. **KANSAS** Sec. 9 Twp. 32 R. 1 ^E

Well No. 1 Harkins

Waits Phillips Company

Contractor

FIRST REPORT

SECTION PLAT

----- Ft. from N. Line
330 Ft. from S. Line
----- Ft. from E. Line
330 Ft. from W. Line

		0	

Location

Rig up -----

Drilling and Remarks:

RECORD

Cased ----- in., ----- ft.
Sand -----
Gas -----
Oil -----
Total Depth -----

PRODUCTION

1st 24 hrs. Nat. -----
1st 24 hrs. after shot -----
Gas ----- Cu. Ft.
Dry Hole -----
Abandoned -----

Date NOV 6 1924

M. A. BENEAR

----- 192 ----- Scout




Contractor

ABANDONED SECTION PLAT

----- Ft. from N. Line

330 Ft. from S. Line

----- Ft. from E. Line

330 Ft. from W. Line

		0	

Location -----

Rig up -----

Drilling and Remarks:

Tap L. 35 85
Wilson 40 85
404A-4138
H.F.W.

RECORD

Cased ----- in., ----- ft.

Sand -----

Gas -----

Oil -----

Total Depth -----

PRODUCTION

1st 24 hrs. Nat. -----

1st 24 hrs. after shot -----

Gas ----- Cu. Ft.

Dry Hole -----

Abandoned -----

Date **MAY 16 1925**

M. A. BENEAR

MAP No. 51 SEC. 9 TWP. 32S R. 1E

WELL No. 1/1000
W. Phillips COMPANY

CONTRACTOR _____

*OK with
 well walling*

SECTION PLAT

		0	

_____ FT. FROM N. LINE
 _____ FT. FROM S. LINE
 _____ FT. FROM E. LINE
 _____ FT. FROM W. LINE

LOCATION _____

RIG UP _____

DRILLING AND REMARKS:

*H. J. H.
 4175-32. Wilson*

RECORD

CASED _____ IN., _____ FT.
 SAND _____
 GAS _____
 OIL _____
 TOTAL DEPTH 4138

PRODUCTION

1ST 24 HRS. NAT. _____
 1ST 24 HRS. AFTER SHOT _____
 GAS _____ CU. FT.
 DRY HOLE _____
 ABANDONED _____

DATE

5/13 1925 SCOUT