


Map No. Kansas Sec. 3 Twp. 32 R. 2-E
 Well No. 1- Barnes Farm _____
Staling Etal. Company

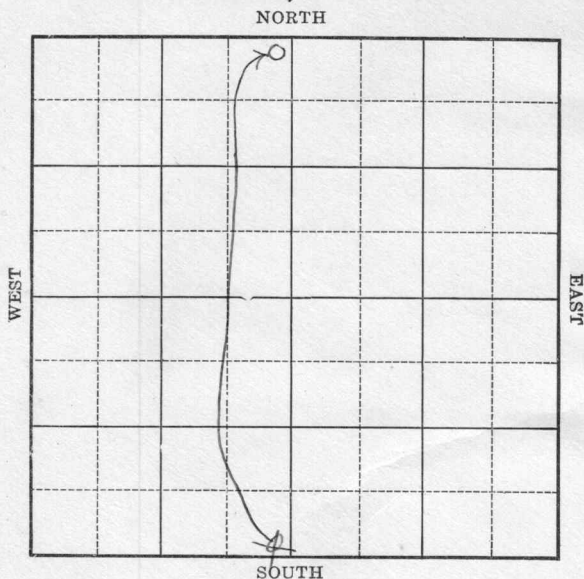

Location _____

Drilling Remarks

Rig Up _____

Drilling Remarks

RECORD

Cased _____ in. _____ ft.

Sand _____

Gas _____

Oil _____

Total Depth _____

PRODUCTION

1st 24 hrs. Nat. _____

1st 24 hrs. after shot _____


Gas _____ cu. ft.

Dry Hole _____

Abandoned _____

Map No. Kansas Sec. 3 Twp. 32 R 2EWell No. 1 Barnes FarmStaling et al Company330 Ft. from N. Line~~330~~ Ft. from S. Line330 Ft. from E. Line

Ft. from W. Line

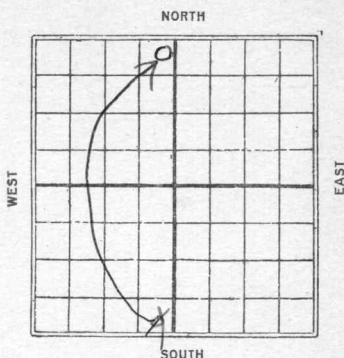

Date	REPORT
1926	
4/7	Location
4/13	
5/5	Same
5/12	
5/26	Cellar
6/2	Rig.
6/9	
6/16	Spud 110'
6/23	Drlg 250'
6/30	" 425'
7/14	" 720'
7/22	" 1530'
8/11	" 2425'
8/18	" 2540'
8/25	" 2935'
9/1	" 3150'
9/8	" 3435'
	top line at 3320'
9/15	Drlg 3550'
9/22	" 3685'
9/29	IL. 3812 - H.F.W. S.D.
10/6	3812 - S.D. High water

10/13 - S.D. 3812

10/20 -

10/27 -

11/3 -

11/10 - same

11/24 - L.D. 3812

D & A.

Map No. **KANSAS** Sec. 3 Twp. 32 R. 2E

Well No. 1 Barnes

Staling & Co Company

Contractor

SECTION PLAT

_____ Ft. from N. Line

330 Ft. from S. Line

330 Ft. from E. Line

_____ Ft. from W. Line

FIRST REPORTS

Location _____

Rig up _____

Drilling and Remarks:

Location.

RECORD

Cased _____ in., _____ ft.

Sand _____

Gas _____

Oil _____

Total Depth _____

PRODUCTION

1st 24 hrs. Nat. _____

1st 24 hrs. after shot _____

Gas _____ Cu. Ft.

Dry Hole _____

Abandoned _____

Date

APR 7 1926

S. J. LEWIS

Scout

Summer
 Map No. **KANSAS** Sec. *3* Twp. *32* R. *2E*

Well No. *1 E E Rice*

Staling & Co Company

Contractor


SECTION PLAT

330 Ft. from N. Line

_____ Ft. from S. Line

330 Ft. from E. Line

_____ Ft. from W. Line

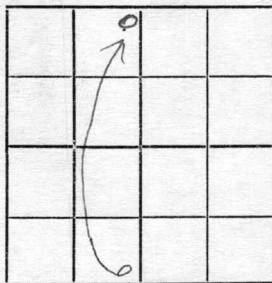

Correction

Location _____

Rig up _____

Drilling and Remarks:

*I reported this
 in SE SW,
 should be
 NE NW.*

RECORD

Cased _____ in., _____ ft.

Sand _____

Gas _____

Oil _____

Total Depth _____

PRODUCTION

1st 24 hrs. Nat. _____

1st 24 hrs. after shot _____

Gas _____ Cu. Ft.

Dry Hole _____

Abandoned _____

Date

APR 20 1924

S. J. LEWIS

Scout

Map No. **KANSAS** Sec. 3 Twp. 32 R. 2E

Well No. 1 EE Rice

Staling & Co. Company

Contractor

SECTION PLAT


330 Ft. from N. Line

----- Ft. from S. Line

330 Ft. from E. Line

----- Ft. from W. Line

ABANDONED

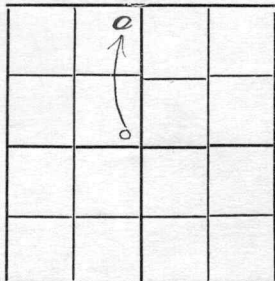

Location -----

Rig up -----

Drilling and Remarks:

TII 3812

J & H

RECORD

Cased ----- in., ----- ft.

Sand -----

Gas -----

Oil -----

Total Depth -----

PRODUCTION

1st 24 hrs. Nat. -----

1st 24 hrs. after shot -----

Gas ----- Cu. Ft.

Dry Hole -----

Abandoned -----

Date

NOV 24 1926

192 S. J. LEWIS Scout

1st report shows
This well located
W N - 34 - 38

Contractor

SECTION PLAT

Pl. from N. Line

Pl. from S. Line

Pl. from E. Line

Pl. from W. Line

ABANDONED

RECORD

Gasch in
Sand
Gas
Oil
Total Depth

Location

Hit up

Drilling and Remarks

PRODUCTION

1st 24 hrs. Nat.
1st 24 hrs. after shot
Gas
Oil
Dry Hole
Abandoned

Returned
Cards
Tracing
France Map
Scarborough Map
Moody Map
Scarborough Plat Book
Moody Plat Book

MAP NO. K1 KANSAS SEC. 3 TWP. 37S R. 2E

WELL No. 1 Rice

Stalling et al COMPANY

CONTRACTOR

SECTION PLAT

	0		

_____ FT. FROM N. LINE

_____ FT. FROM S. LINE

_____ FT. FROM E. LINE

_____ FT. FROM W. LINE

RECORD

LOCATION _____

CASED _____ IN. _____ FT.

RIG UP _____

SAND _____

DRILLING AND REMARKS:

GAS _____

OIL _____

TOTAL DEPTH 3814

PRODUCTION

1ST 24 HRS. NAT. _____

1ST 24 HRS. AFTER SHOT _____

GAS _____ Cu. Ft.

DRY HOLE _____

ABANDONED _____

DATE

12/8 1926 SCOUT