

Butler

Map No. 15 Sec. 3 Twp. 28 R. 6

Well No. T-Kramer Farm


Alisono Fitzwilliams Company

990 Ft. from N. Line

_____ Ft. from S. Line

_____ Ft. from E. Line

330 Ft. from W. Line

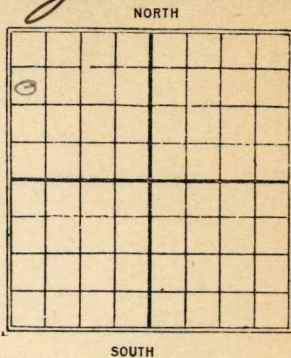

1926

Date	REPORT
12/30	Bldg rig
1927	
1/6	same
1/13	Rigging up
1/19	Rig only
1/26	same
2/3	_____
2/10	_____
2/17	_____
2/24	_____
3/2	_____
3/9	_____
3/16	Drlg 500
3/24	" 1300
3/30	" 2150
4/7	Setting 6"-2840
4/13	Drilling 3030
4/20	_____
4/27	Sand 3082-3092 125 bbls

11 **KANSAS** *Butter*
Map No. _____ Sec. *3* Twp. *28* R. *6*

Well No. *7* *Kramer*
Harrison & Fitzwilliams Company

Contractor _____

FIRST REPORTS

SECTION PLAT

990 Ft. from N. Line
_____ Ft. from S. Line
_____ Ft. from E. Line
330 Ft. from W. Line

o			

Location _____
Rig up _____
Drilling and Remarks:

Blow rig

RECORD

Cased _____ in., _____ ft.
Sand _____
Gas _____
Oil _____
Total Depth _____

PRODUCTION

1st 24 hrs. Nat. _____
1st 24 hrs. after shot _____
Gas _____ Cu. Ft.
Dry Hole _____
Abandoned _____

Date
DEC 30 1926

CHAS. L. SHERWOOD

102 _____ Scout

11 Map No. **KANSAS** Sec. *3* Twp. *28* R. *6*

Well No. *7* *Kramer*

Allison & Fitzwilliams Company

Contractor

COMPLETED

SECTION PLAT

990 Ft. from N. Line

Ft. from S. Line

Ft. from E. Line

330 Ft. from W. Line

0			

Location

Rig up

Drilling and Remarks:

125 *lb.*

RECORD

Cased *3* in., *2092* ft.

Sand *2082-2092*

Gas

Oil

Total Depth *2092*

PRODUCTION

1st 24 hrs. Nat.

1st 24 hrs. after shot

Gas Cu. Ft.

Dry Hole

Abandoned

Date

APR 27 1907

CHAS. L. SHERWOOD

192

Scout