
FORM 51

Sumner KANSAS

Section 7 Township 32 Range 2 E

Well No. # 1 Black "A"

Company National Assoc. Pet.

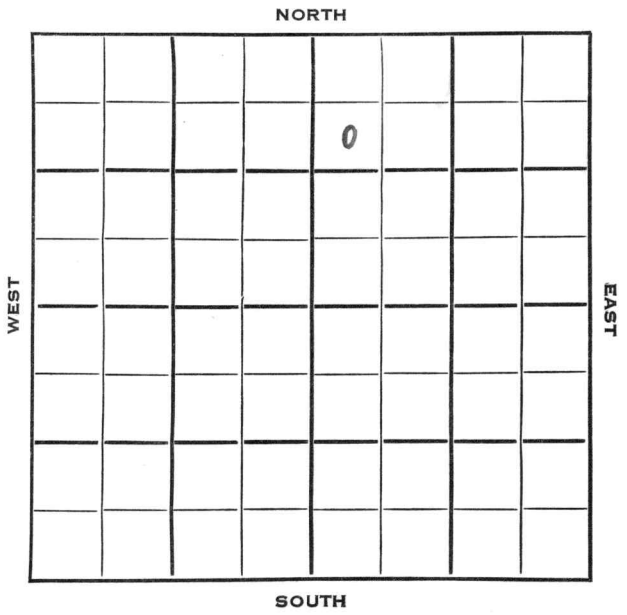

Sumner

SEC.	TWP.	R. KANSAS ✓
7	32	2E

WELL NO.

1 Black "A" FARM

COMPANY

National Assoc. Petr.

CONTRACTOR

Brack

Metz Pool


990 Ft. from N. Line

_____ Ft. from S. Line

_____ Ft. from E. Line

330 Ft. from W. Line

SW NW NE

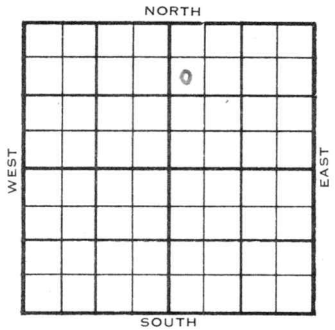

1953	ELEVATION ----	REPORT
10/28		Spud 10-15-53 8" @ 148' Drlg. 3650'
12/2		Spud 10-15-53 Oil well TD 3800' 8" @ 148 Lans. 2843' Bart 3359' Miss 3416 Kh. 3716 Simp. 3755 Arb. 3769 TD 3800' 5" @ 3799 CO to 3800 S/3 BO 1 BWPH Comp. 30 BOPD 40 Bw

COMPLETED

DX-78

FORM 275 FOR SALE BY KANSAS BLUE PRINT CO.

County Sumner State Kansas

Sec. 7 (Blk. Twp.) 32 (Sur. Rge.) 2E Map No.

Operator National Assoc. Pet.

Well No. 1 Farm Black "A"

Elev. Location SW NW NE



990 Ft. From N Line NE

330 Ft. From W Line Quarter

1st. Report OCT 28 1953

Completion

Remarks

Brack - Contr.

Spudding Date 10-15-53

Drlg. Data Metz Pool

8" @ 148 drlg. 3650

J. G. McGEHEE

FORM 275 FOR SALE BY KANSAS BLUE PRINT CO.


County Sumner State Kansas

Sec. 7 (Blk. Twp.) 32 (Sur. Rge.) 2E Map No.

Operator National Assoc. Pet.

Well No. 1 Farm Black "A"

Elev. Location SW NW NE

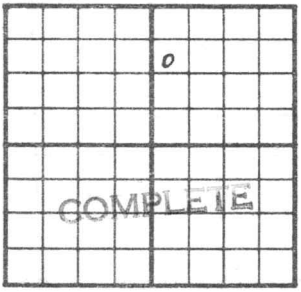

990 Ft. From N Line NE

330 Ft. From W Line Quarter

1st. Report

Completion DEC 2 1953

Remarks Metz Pool

Brack - Contr.

Spudding Date 10-15-53

Drlg. Data Oil well TD 3800

8" @ 148 Lans. 2843 Bart. 3359

Miss. 3416 Kh. 3716 Simp. 3755

Arb. 3769 TD 3800 5" @ 3799

CO to 3800 S/ 3 bo 1 bwph

Comp. 30 bopd 40 bw

J. G. McGEHEE