


Map No. _____ Sec. 4 Twp. 28 R. 6
 Well No. 6 - Blakeman Farm
Magnolia Pet Company

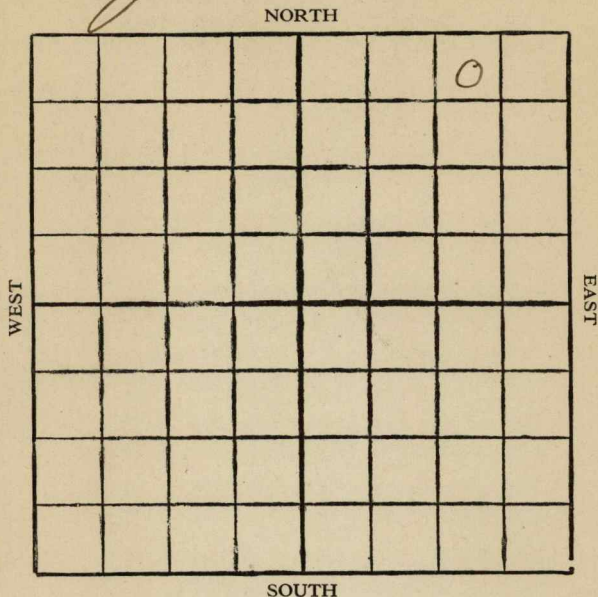

Location

Drilling Remarks

.....

.....

RECORD

Cased in. ft.

Sand

Gas

Oil

Total Depth

Rig Up

Drilling Remarks

.....

.....

PRODUCTION

1st 24 hrs. Nat.

1st 24 hrs. after shot


Gas cu. ft.

Dry Hole

Abandoned

Map No. Kansas Sec. 4 Twp. 28 R. 6
 Well No. 6 Blakeman Farm
magnolia Company

NORTH

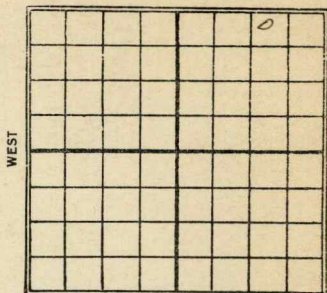

330 Ft. from N. Line

_____ Ft. from S. Line

_____ Ft. from E. Line

990 Ft. from W. Line

SOUTH

Date

REPORT

Date	REPORT
1927	
5/25	Bldg Rig
6/1	Rig
6/7	Rgn. up
6/15	Drlg 990
6/22	" 1600
6/29	" 2115
7/7	" 2230'
7/13	" 2680'
7/20	Top line 2815 show - Drlg 2860.
7/28	Drlg 3002-
8/3	3079-3086
	Top line 2815-3003
	100 bbls
	T.O. 3086'

Butter

11 **KANSAS** Map No. Sec. 4 Twp. 28 R. 6Well No. 6 Blackman
Magnolia Pet Co Company

Contractor

FIRST REPORTS**SECTION PLAT**

330

Ft. from N. Line

Ft. from S. Line

990

Ft. from E. Line

Ft. from W. Line

			0

Location

Rig up

Drilling and Remarks:

Bog Rig

RECORD

Cased _____ in., _____ ft.

Sand _____

Gas _____

Oil _____

Total Depth _____

PRODUCTION

1st 24 hrs. Nat. _____

1st 24 hrs. after shot _____

Gas _____ Cu. Ft.

Dry Hole _____

Abandoned _____

Date

MAY 25 1927

CHAS. L. SHERWOOD

192

Scout

Butler
 11 **KANSAS** Sec. 4 Twp. 28 R. 6
 Map No. 6 Hageman
 Well No. magnolia pet co Company
 Contractor

COMPLETED**SECTION PLAT**

330 Ft. from N. Line
 Ft. from S. Line
 990 Ft. from E. Line
 Ft. from W. Line

			0

Location

Rig up

Drilling and Remarks:

Top Line 2815-3003

100 bl.

RECORD

Cased in., 3086 ft.
 Sand 3079-3086
 Gas
 Oil
 Total Depth 3086

PRODUCTION

1st 24 hrs. Nat.
 1st 24 hrs. after shot
 Gas Cu. Ft.
 Dry Hole
 Abandoned

Date

AUG 3 1927

CHAS. L. SHERWOOD

192

Scout