
FORM 51 25M 8-50 WESTERN Butler KANSAS

Section 4 Township 28 Range 6E

Well No. #1 Cline

Company R. J. Wixson & Tom Palmer

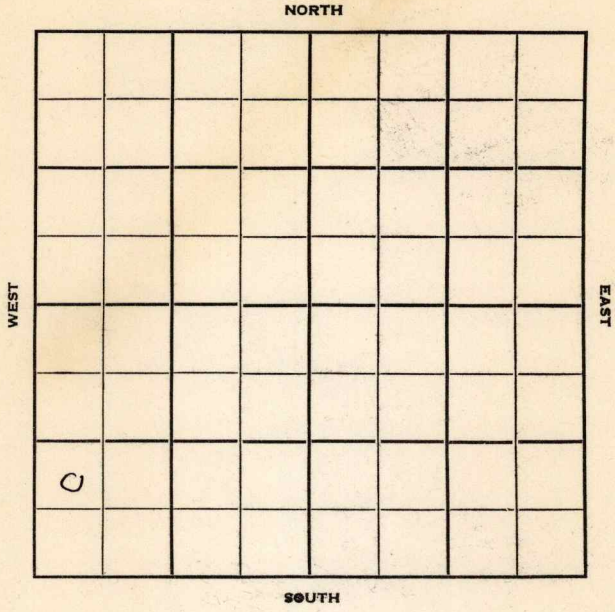

FORM 252-B
10M 10-50 PETROL

Butler KANSAS ✓

Sec. 4 Twp. 28 R. 6E

Well No. #1 Cline Farm

R. J. Wixson & Tom Palmer Company

Wixson - Contr. Contractor

Semi-Wildcat


_____ Ft. from N. Line

990' Ft. from S. Line

_____ Ft. from E. Line

330' Ft. from W. Line

NW SW SW

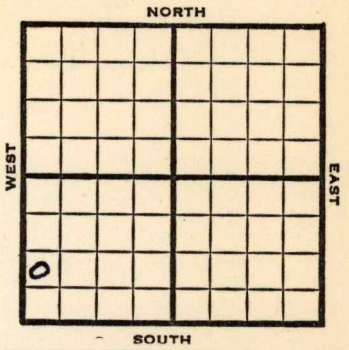


| 1952 | Elev. 1373' REPORT |
|---|---|
| 7/23 | Spud 7-19-52<br>Drlg. 210 |
| 8/27 | Spud 7-19-52<br>D&A TD 3075' 13" @ 905<br>10" @ 1685 KC 2090<br>8" @ 2115 7" @ 2760<br>Miss 2765 B. Miss 2990<br>Viola 3007<br>TD 3075 D&A<br>ABANDONED |

FORM 275 FOR SALE BY KANSAS BLUE PRINT CO.

County Butler State Kansas

Sec. 4 (Blk. / Twp.) 28 (Sur. / Rge.) 6E Map No.

Operator R. J. Wixson & Tom Palmer

Well No. 1 Farm Cline

Elev. Location NW SW SW




990 Ft. From S Line SW

330 Ft. From W Line Quarter

1st. Report JUL 23 1952

Completion

Remarks

Wixson - Contr.

Spudding Date 7-19-52

Drlg. Data Semi Wildcat

drlg. 210

J. G. McGehee

FORM 275 FOR SALE BY KANSAS BLUE PRINT CO.


County Butler State Kansas

Sec. 4 (Blk. Twp.) 28 (Sur. Rge.) 6E Map No.

Operator R. J. Wixson & Tom Palmer

Well No. 1 Farm Cline

Elev. 1373 Location NW SW SW

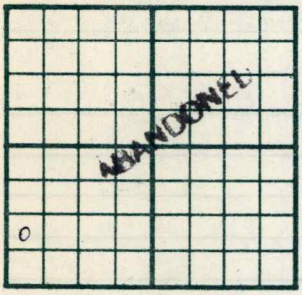


990 Ft. From S Line SW

330 Ft. From W Line Quarter

1st. Report

Completion AUG 27 1952

Remarks Semi Wildcat

Wixson - Contr.

Spudding Date 7-19-52

Drlg. Data D & A TD 3075

13" @ 905 10" @ 1685 KC 2090

8" @ 2115 7" @ 2760 Miss. 2765

B. Miss. 2990 Viola 3007 TD 3075

D & A

J. G. McGEHEE