

Map No. 1-1 Sec. 32 Twp. 32 R. 2EWell No. 1-1 Lot 11, Blk 35 Farm 08

Company

NORTH

WEST

EAST

SOUTH

Location

Drilling Remarks

Rig Up

Drilling Remarks

RECORD

Cased _____ in. _____ ft.

Sand _____

Gas _____

Oil _____

Total Depth _____

PRODUCTION

1st 24 hrs. Nat. _____

1st 24 hrs. after shot _____

Gas _____ cu. ft. _____

Dry Hole _____

Abandoned _____

KANSAS

Map No. _____ Sec. 11 Twp. 32 R. 2E

Well No. 1- Townlot 7w Farm _____

Deel 00 1/2

Company _____

Lot 11, Blk 35

_____ Ft. from N. Line


75

_____ Ft. from S. Line

1010

_____ Ft. from E. Line

_____ Ft. from W. Line

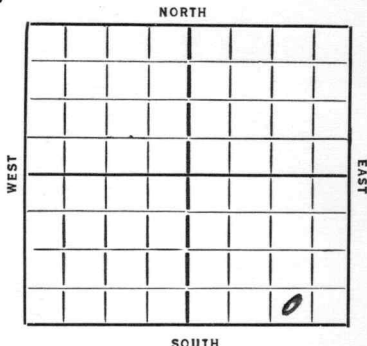

REPORT

2/26

2/5 Dig Celler

2/14 B.R.

2/21 SD

2/28 Rig

3/13 T. Stal. 2048' Drlg 2155

3/20 T.K.C. 2465 Coring @ 2928.

3/27 7" - 2928' Bailing.

4/2 T. Simp 2990' Drlg. 3024' 1 bailer oil per day.

4/8 Sand 2990-3002

TD 3031

pot 661

COMPLETED

Map No. 1 Sec. 11 Twp. 32 R. 2E

Well No. 1 - Townlot Fee

Deal O. & G Company

Contractor
LOT 11. BLK-35
SECTION PLAT


.....Ft. from N. Line

75 Ft. from S. Line

1010 Ft. from E. Line

.....Ft. from W. Line

FIRST REPORT

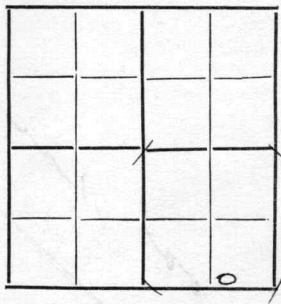

Location.....

Rig up.....

Drilling and Remarks:

Dig. cellar

RECORD

Cased.....in.,ft.

Sand.....

Gas.....

Oil.....

Total Depth.....

PRODUCTION

1st 24 hrs. Nat.....

1st 24 hrs. after shot.....

Gas.....Cu. Ft.

Dry Hole.....

Abandoned.....

Date

FEB 5 1926

ORVAL MANNSCHRECK

Scout

Map No. 1 Sec. 11 Twp. 32 R. 2E

Well No. 1 Town & Sec.

Deal O & G. Company

Contractor

SECTION PLAT

Ft. from N. Line

75 Ft. from S. Line

1010 Ft. from E. Line

Ft. from W. Line

COMPLETE

Location

Rig up

Drilling and Remarks:

Sand 2990-3002.

Potential 661

RECORD

Cased in., ft.

Sand

Gas

Oil

Total Depth 3031

PRODUCTION

1st 24 hrs. Nat.

1st 24 hrs. after shot

Gas Cu. Ft.

Dry Hole

Abandoned

Date

4/8/36 192

S. J. LEWIS

Scout