


*Summer*Map No. _____ Sec. *11* Twp. *32* R. *2E*Well No. *1 - Townsite* Farm _____*Tom Finestatal* CompanyNW Cor Lot 4 Blk 18
second date.

Ft. from N. Line

970 Ft. from S. Line*550* Ft. from E. Line

Ft. from W. Line

NORTH

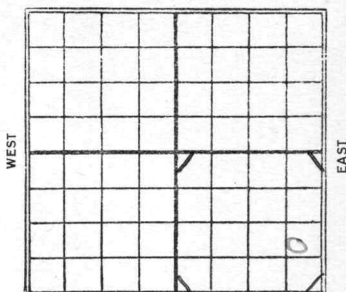

SOUTH

1927

Date

REPORT

<i>6/15</i>	<i>Machine</i>
<i>6/22</i>	<i>Rigging up</i>
<i>6/29</i>	
<i>7/6</i>	<i>Drlg 290</i>
<i>7/13</i>	<i>" 460</i>
<i>7/20</i>	<i>" 715</i>
<i>7/27</i>	<i>" 955</i>
<i>8/3</i>	<i>Run'g 10" @ 1031</i>
<i>8/10</i>	<i>Drlg -13 22</i>
<i>8/17</i>	<i>" 14 20</i>
<i>8/24</i>	<i>" 15 45</i>
<i>8/31</i>	<i>" 16 83</i>
<i>9/7</i>	<i>" 18 10</i>
<i>9/14</i>	<i>Top sd. 2096 - oil 2101 - T.D. 2105</i>
<i>9/20</i>	<i>T.D. 2154 - S.D. show oil -</i>
<i>9/28</i>	<i>—</i>
<i>10/5</i>	<i>—</i>
<i>10/12</i>	<i>P.B. to 2122 - 40qt shot</i>
	<i>2105-22 - 1800' oil in hole 48 hrs.</i>
<i>10/19</i>	<i>Putting on pump-</i>
<i>10/26</i>	<i>Pumped 4 bbls - S.D.</i>
<i>11/2</i>	<i>S.D.</i>

11/9- T.D. 2154 S. & A.

Map No. KANSAS Sec. 11 Twp. 32 R. 2E

Well No. 1 Monomite

Mon Finc & Co. Company

Contractor

Cover 2083 Block 18

Oxford Monomite

SECTION PLAT

_____ Ft. from N. Line

970 Ft. from S. Line

550 Ft. from E. Line

_____ Ft. from W. Line

			0

FIRST REPORTS

Location _____

Rig up _____

Drilling and Remarks:

Machine

RECORD

Cased _____ in., _____ ft.

Sand _____

Gas _____

Oil _____

Total Depth _____

PRODUCTION

1st 24 hrs. Nat. _____

1st 24 hrs. after shot _____

Gas _____ Cu. Ft.

Dry Hole _____

Abandoned _____

Date

JUN 15 1927

S. J. LEWIS

102

Scout

Map No. **KANSAS** Sec. 11 Twp. 32 R 2E

Well No. #1 Townsite

Tom Fine & Co Company

Contractor

NW cor Lot 8 Block 18
Oxford townsite

SECTION PLAT

----- Ft. from N. Line

----- Ft. from S. Line

----- Ft. from E. Line

----- Ft. from W. Line

Correction

Location -----

Rig up -----

Drilling and Remarks:

Reported this
in B.W. cor Lot 8
3. should be.
NW cor Lot 8

RECORD

Cased ----- in., ----- ft.

Sand -----

Gas -----

Oil -----

Total Depth -----

PRODUCTION

1st 24 hrs. Nat. -----

1st 24 hrs. after shot -----

Gas ----- Cu. Ft.

Dry Hole -----

Abandoned -----

Date

JUN 22 1927

S. J. LEWIS

192

Scout

Map No. KANSAS Sec. 11 Twp. 32 R. 24

Well No. 1 Howrsite

Tom Fine & Co Company

Oxford townsite Contractor

Lot 4 Blk 18

SECTION PLAT

			0

-----Ft. from N. Line

970 Ft. from S. Line

550 Ft. from E. Line

-----Ft. from W. Line

ABANDONED

Location -----

Rig up -----

Drilling and Remarks:

TJ 2154

TJA

RECORD

Cased ----- in., ----- ft.

Sand -----

Gas -----

Oil -----

Total Depth -----

PRODUCTION

1st 24 hrs. Nat. -----

1st 24 hrs. after shot -----

Gas ----- Cu. Ft.

Dry Hole -----

Abandoned -----

Date

NOV 9 1927

S. J. LEWIS

Scout

MAP NO. K1 KANSAS SEC. 11 TWP. 37S R. 2E

WELL NO. 1 20m Fine
20m Fine

COMPANY

CONTRACTOR

SECTION PLAT

_____ FT. FROM N. LINE

_____ FT. FROM S. LINE

_____ FT. FROM E. LINE

_____ FT. FROM W. LINE

LOCATION _____

RIG UP _____

DRILLING AND REMARKS:

Lat 35 1/2
Blk 18
on

RECORD

CASED _____ IN. _____ FT.

SAND _____

GAS _____

OIL _____

TOTAL DEPTH 2154

PRODUCTION

1ST 24 HRS. NAT. _____

1ST 24 HRS. AFTER SHOT _____

GAS _____ CU. FT.

DRY HOLE _____

ABANDONED _____

DATE

11/15 192 4 SCOUT