

Map No. _____ Sec. 11 Twp. 32 R. 2 E

Well No. 1-Lot 8-Blk 85 Farm _____


Shawver et al Company

_____ Ft. from N. Line

105 Ft. from S. Line

_____ Ft. from E. Line

843 Ft. from W. Line

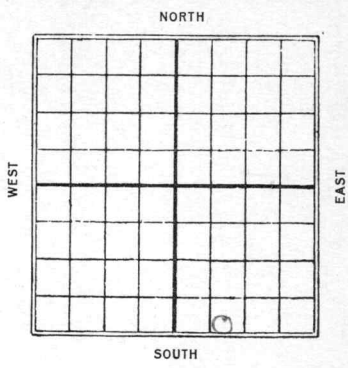

1927

Date	REPORT
8/10	Location
8/17	—
8/24	Rig building
8/31	Rigging up.
9/7	Spud.
9/14	Drlg 540
9/20	" 860
9/28	T.D. 1065-fishing tools-
10/5	Drlg 1340
10/12	" 1385
10/19	" 1595
10/26	" 1790
11/2	T.S. 2053 T.D. 2138
—	Swabbing 5 bbls per hr.
11/9	T.S. 2053 T.D. 2138
—	5 bbls per hour Nat.
—	140 gts 2070-2138
—	Swabbing 800 bbl

Map No. KANSAS Sec. 11 Twp. 32 R. 2E

Well No. 1 2088-Blk 85

Shawver & Co. Company

Oxford Townsite Contractor

SECTION PLAT

----- Ft. from N. Line

105 Ft. from S. Line

----- Ft. from E. Line

843 Ft. from W. Line

FIRST REPORTS

Location ✓-----

Rig up -----

Drilling and Remarks:

RECORD

Cased ----- in., ----- ft.

Sand -----

Gas -----

Oil -----

Total Depth -----

PRODUCTION

1st 24 hrs. Nat. -----

1st 24 hrs. after shot -----

Gas ----- Cu. Ft.

Dry Hole -----

Abandoned -----

Date

AUG 10 1927

192

S. J. LEWIS Scout

Map No. KANSAS Sec. 11 Twp. 32 R. 2E

Well No. 1 Lot 8. Blk. 85

Shawver et al Company

Oppedtownite Contractor

SECTION PLAT

----- Ft. from N. Line

105 Ft. from S. Line

----- Ft. from E. Line

843 Ft. from W. Line

COMPLETED

Location -----

Rig up -----

Drilling and Remarks:

T.S. 2053
T.D. 2138
5886 per hr. Nat.
140/2070-2138
swabbing 80086

RECORD

Cased ----- in., ----- ft.
 Sand -----
 Gas -----
 Oil -----
 Total Depth -----

PRODUCTION

1st 24 hrs. Nat. -----
 1st 24 hrs. after shot -----
 Gas ----- Cu. Ft.
 Dry Hole -----
 Abandoned -----

Date

NOV 9 1927

S. J. LEWIS

192

Scout