

Map No.

KANSAS

Sec.

3

Twp.

14

R.

Ellis 17W

Well No.


21-
Swin

Farm

Company

NORTH

WEST

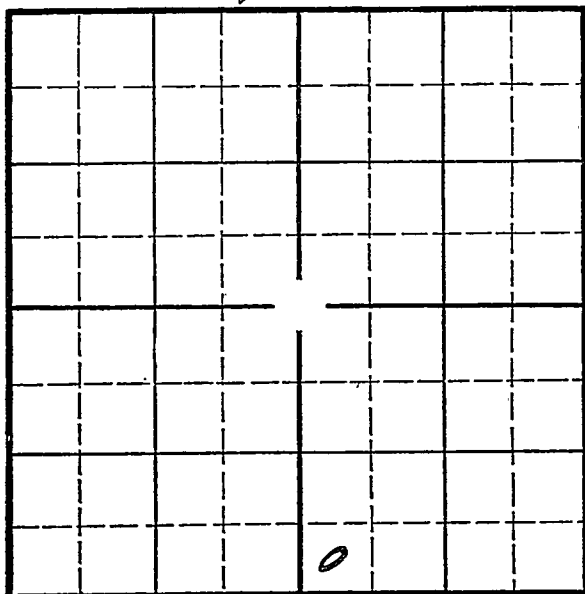

EAST

SOUTH

O. W. D. D

Location

Drilling Remarks

Rig Up

Drilling Remarks

RECORD

Cased _____ in. _____ ft.

Sand _____

Gas _____

Oil _____

Total Depth _____

PRODUCTION

1st 24 hrs. Nat. _____

1st 24 hrs. after shot _____

Gas _____ cu. ft. _____

Dry Hole _____

Abandoned _____

KANSAS

Map No. _____ Sec. 3 Twp. 14 R. 17W

Well No. 5 Gooty Farm _____

Twin Blg Company _____


_____ Ft. from N. Line

330 Ft. from S. Line

_____ Ft. from E. Line

330 Ft. from W. Line

Elev. 2001

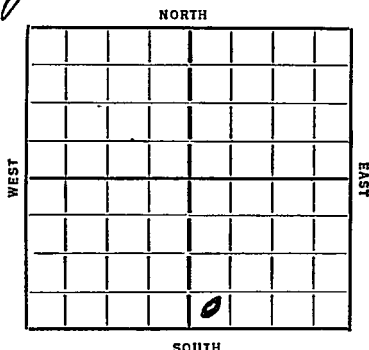

Date 1935

REPORT

O. W. D. D

9/12 Gooty
10/3 Apex & S.D.
10/10 11/1
11/7 Blg 15.90 13" 1181
11/14 " 2400 Amber 1181
11/21 " 2915 10" 2465 8" 2800
11/29 sp 3200 TP 3245 SD.
12/6 Top Oswald 3273
24" W 3278 6" 3278
1 1/2 Barrels Oil per hr. 3283
Pay 3298-3302
2500.01 H 10" 2 hrs
Armed 92 Oil 2 hrs
56 Oil next 7 hrs.
TD 3303 1/2 SD for Tanks
12/13 TP 3303 1/2
P. 214 Blgs on pot test
24 hrs Will acidize
12/19 ABP & rung rods

OVER

12/23 Oswald 3273
TD 3303 1/2
6000 Gal acid
928 Hbl.

COMPLETED

1937

O. W. D. D

1/20 Sil. 3502'. T. D. 3568'.
Shot. 20 qts. 1000 acid.
Pot. 653 oil 25 water.

FIRST REPORTS

and

COMPLETED

711515

Map No. 71 Sec. 3 Twp. 14 R. 17W

Well No. 1-Boetz

Twin Bay Company

Contractor

FIRST REPORTS

SECTION PLAT

Ft. from N. Line

330 Ft. from S. Line

Ft. from E. Line

330 Ft. from W. Line

Location

Rig up

Drilling and Remarks:

cellar

RECORD

Cased in, ft.

Sand

Gas

Oil

Total Depth

PRODUCTION

1st 24 hrs. Nat.

1st 24 hrs. after shot

Gas Cu. Ft.

Dry Hole

Abandoned

Date

ORVAL MANNSCHRECK

9-17-35

192

Scout

KANSAS

Map No. 71 Sec. 3 Twp. 14 R. 17WWell No. 1-BoetzTravis Reg Co Company

Contractor

COMPLETE

SECTION PLAT

		0	

Ft. from N. Line

330 Ft. from S. Line

Ft. from E. Line

330 Ft. from W. Line

Location

Rig up

Drilling and Remarks:

6000 gallons928 bbls

RECORD

Cased in. ft.

Sand Quartz 3273

Gas

Oil

Total Depth 3303 1/2

PRODUCTION

1st 24 hrs. Nat.

1st 24 hrs. after shot

Gas Cu. Ft.

Dry Hole

Abandoned

Date

12-23-35 192

J. V. A. H. 126

Scout

Map No. 71 Sec. 3 Twp. 14 R. 17W.

Well No. 1 G & T

Twin Well Company

J Contractor

SECTION PLAT

_____ Ft. from N. Line

330 Ft. from S. Line

_____ Ft. from E. Line

330 Ft. from W. Line

**FIRST REPORT
COMPLETED**

OW 717

Location _____

Rig up _____

Drilling and Remarks:

Oil 3502
Shot 209 ft.
#000 acid
P & 653 oil
25 water

RECORD

Cased _____ in., _____ ft.

Sand _____

Gas _____

Oil _____

Total Depth 3568.

PRODUCTION

1st 24 hrs. Nat. _____

1st 24 hrs. after shot _____

Gas _____ Cu. Ft.

Dry Hole _____

Abandoned _____

Date

JAN 24 1937

S. J. LEWIS Scout