

Map No. *Butler* **KANSAS** Sec. *60* Twp. *28* R. *6 E*

Well No. *1* *Butler* Farm
Blakeslee & Kentz Company

NORTH

| | | | | | | | |
|--|--|--|--|--|--|---|--|
| | | | | | | | |
| | | | | | | | |
| | | | | | | | |
| | | | | | | | |
| | | | | | | 0 | |
| | | | | | | | |
| | | | | | | | |
| | | | | | | | |

WEST

EAST

SOUTH

Location.....

Rig Up.....

Drilling Remarks

Drilling Remarks

.....

.....

RECORD

PRODUCTION

Cased..... in..... ft.

Sand.....

Gas.....

Oil.....

Total Depth.....

1st 24 hrs. Nat.....

1st 24 hrs. after shot.....

Gas..... cu. ft.....

Dry Hole.....

Abandoned.....

Map No. **KANSAS**, Sec. 69 Twp. 28 R. 6^E

Well No. 17 Letter Farm


Blakuslee & Wentz Company

330 Ft. from N. Line

_____ Ft. from S. Line

990 Ft. from E. Line

_____ Ft. from W. Line

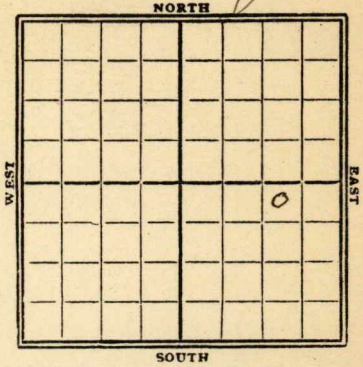

1929

Date

REPORT

| Date | REPORT |
|-------|----------------------|
| 7/2 | Reg |
| 7/10 | Ramp |
| 7/17 | Spdy |
| 7/24 | SD |
| 7/31 | — |
| 8/7 | — |
| 8/14 | — |
| 8/21 | — |
| 8/28 | — |
| 9/4 | — |
| 9/11 | — |
| 9/18 | Orly 730' |
| 9/25 | " 1485' |
| 10/2 | " 1800' |
| 10/9 | " 2300' |
| 10/16 | S/R at 2766' |
| 10/23 | Orly 3100' |
| 10/30 | Melcox 3138-52' HFW |
| | Silc lim 3160-74 HFW |
| | T.D. 3174' |
| | Dry & Abandon. |

Butler

Map No. **KANSAS** Sec. 6 Twp. 28 R. 6 ^E

Well No. *Setter*

Blakeslee & Wentz Company

Contractor

FIRST REPORTS

SECTION PLAT

330 Ft. from N. Line

..... Ft. from S. Line

990 Ft. from E. Line

..... Ft. from W. Line

| | | | |
|--|--|--|---|
| | | | |
| | | | |
| | | | 0 |
| | | | |

Location.....

Rig up

Drilling and Remarks:

RECORD

Cased..... in., ft.

Sand.....

Gas.....

Oil.....

Total Depth.....

PRODUCTION

1st 24 hrs. Nat.....

1st 24 hrs. after shot.....

Gas..... Cu. Ft.

Dry Hole.....

Abandoned.....

Date

7/2

192*9*

CHAS. L. SHERWOOD

Scout

Butler

11 **KANSAS** Map No. _____ Sec. 6 Twp. 28 R. 6

Well No. 1 Getter

Blakeslee & Wentz Company

Contractor

COMPLETE

SECTION PLAT

330 Ft. from N. Line

_____ Ft. from S. Line

990 Ft. from E. Line

_____ Ft. from W. Line

| | | | |
|--|--|--|---|
| | | | |
| | | | |
| | | | o |
| | | | |

ABANDONED

Location _____

Rig up _____

Drilling and Remarks:

Wilcox 3138-52 New

Silc L 3160-74 New

RECORD

Cased _____ in., _____ ft.

Sand _____

Gas _____

Oil _____

Total Depth 3174

PRODUCTION

1st 24 hrs. Nat. _____

1st 24 hrs. after shot _____

Gas _____ Cu. Ft.

Dry Hole

Abandoned

Date

OCT 30 1929

19

CHAS. L. SHERWOOD

Scout