


Butler

Form 51-5M-11-31-Palace

Map No. **KANSAS** Sec. 6 Twp. 28 R. 6 E

Well No. 1 d. Getter Farm

Cromwell & Lewis Company

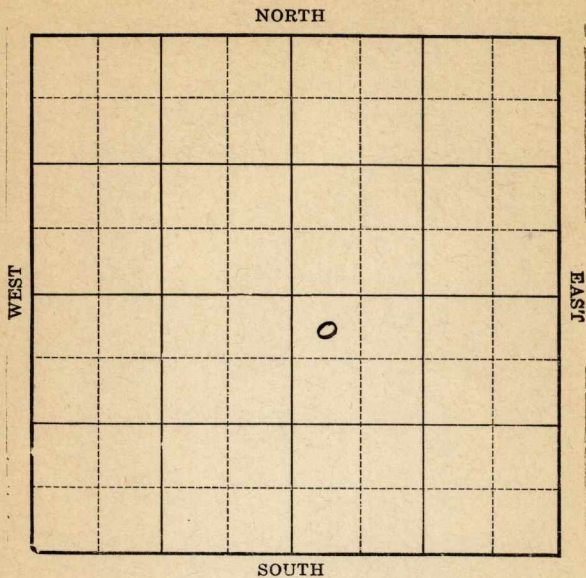

Location _____

Drilling Remarks _____

Rig Up _____

Drilling Remarks _____

RECORD

Cased _____ in. _____ ft.

Sand _____

Gas _____

Oil _____

Total Depth _____

PRODUCTION

1st 24 hrs. Nat. _____

1st 24 hrs. after shot _____

Gas _____ cu. ft.

Dry Hole _____

Abandoned _____

Butler

Form 252-A
5M 4-32 MPC

Map No. **KANSAS** Sec. 6 Twp 28 R. 6

Well No. 1 A. Getter Farm


Cromwell & Lewis Company

330 Ft. from N. Line

_____ Ft. from S. Line

_____ Ft. from E. Line

330 Ft. from W. Line

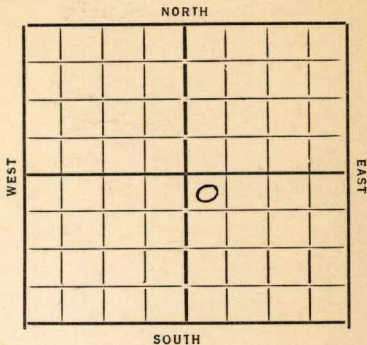

Date
1934

REPORT

2/14 Spud

2/23 Dily 590

3/1 Run 10" at 960

3/8 Dily 1520

3/15 8" at 1651 6" 2009

3/22 _____

3/28 K.C. 2148 75 2155 D-17

ABANDONED

Map No. 11 Sec. 6 Twp. 28 R. 6E

Well No. 1-G. Better

Cromwell Lewis Company

Contractor

FIRST REPORT

SECTION PLAT

330 Ft. from N. Line

..... Ft. from S. Line

..... Ft. from E. Line

330 Ft. from W. Line

		0	

Location.....

Rig up.....

Drilling and Remarks:

Spud

RECORD

Cased..... in., ft.

Sand.....

Gas.....

Oil.....

Total Depth.....

PRODUCTION

1st 24 hrs. Nat.....

1st 24 hrs. after shot.....

Gas..... Cu. Ft.

Dry Hole.....

Abandoned.....

Date

2-14-34 192 O. Mannscheck Scout

Map No. Butter, 11 Sec. 6 Twp. 28 R. 6E

Well No. 1- H. Better

Cromwell + Lewis Company

Contractor

ABANDONED

SECTION PLAT

330 Ft. from N. Line

..... Ft. from S. Line

..... Ft. from E. Line

330 Ft. from W. Line

		o	

Location

Rig up

Drilling and Remarks:

10 + A

RECORD

Cased in. ft.

Sand K.C. 2148

Gas

Oil

Total Depth 2155

PRODUCTION

1st 24 hrs. Nat.

1st 24 hrs. after shot

Gas Cu. Ft.

Dry Hole

Abandoned

Date

3-28-37 O. Mammel Scout