


Map No. 13 Sec. 18 Twp. 21 W
 Well No. #1- A. R. Young Farm
Phillips Pet. Company

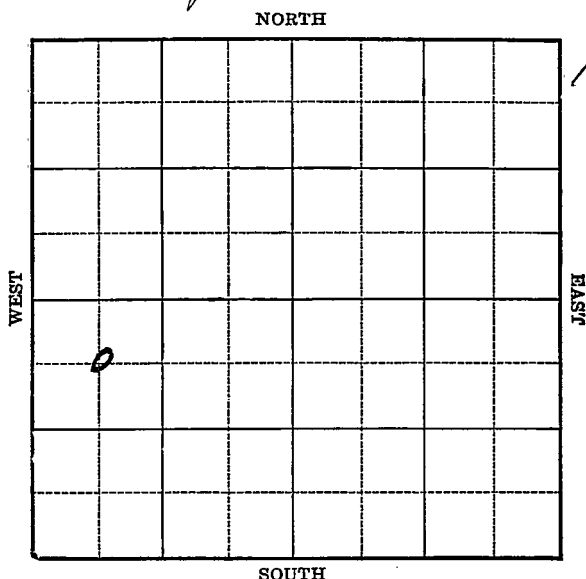

Location _____

Drilling Remarks _____

Rig Up _____

Drilling Remarks _____

RECORD

Cased _____ in. _____ ft.

Sand _____

Gas _____

Oil _____

Total Depth _____

PRODUCTION

1st 24 hrs. Nat. _____

1st 24 hrs. after shot _____

Gas _____ cu. ft.

Dry Hole _____

Abandoned _____

Ken

Map No. _____ Sec. 13 Twp. 18 R. 21 W


Well No. #1 A. R. Young Farm _____
Phillips Pst. Company _____

660 Ft. from N. Line

_____ Ft. from S. Line

_____ Ft. from E. Line

660 Ft. from W. Line

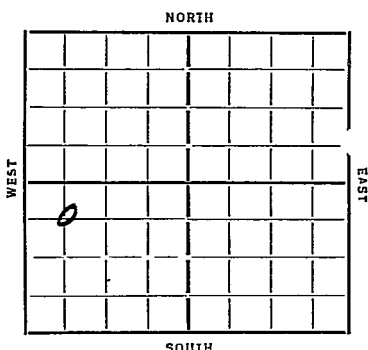

Date 7/35

REPORT

2/13 Cellar
2/21 _____
2/28 Alg 75
3/7 15" 594 WOC
3/14 1500 run 13"
3/21 Alg 2374
3/28 3635 lost circulation
4/4 Alg 3620 Topoka 3235
4/11 KE 3640 8" 3649 Rust
4/18 — 4/26 —
5/2 Alg 3715
5/9 HFW 3715-70
5/16 Alg 3850 6" 3837
5/23 " 3964
5/29 7" 4008 CO.
6/6 HFW 4099-4102 6" 4093
6/13 Alg 4109
6/19 Miss 4156 4160 UR 6"
6/19 TML 4175 T7 4235
70 ft.

ABANDONED

Map No. 75 Sec. 13 Twp. 18 R. 21WWell No. 1- A.R. YoungPhillips Pet. Company

Contractor

KANSAS
FIRST REPORTS660 Ft. from N. Line

Ft. from S. Line

Ft. from E. Line

660 Ft. from W. Line

SECTION PLAT

0			

Location

Rig up

Drilling and Remarks:

Cellar

RECORD

Cased in., ft.Sand Gas Oil Total Depth

PRODUCTION

1st 24 hrs. Nat. 1st 24 hrs. after shot Gas Cu. Ft.Dry Hole Abandoned

Date

2-13-35 192

ORVAL MANNSCHRECK

Scout

KANSAS

Map No. 75 Sec. 13 Twp. 18 R. 21WWell No. 1- H. R. YoungPhillips pet Company

Contractor

ABANDONED

SECTION PLAT

660 Ft. from N. Line

Ft. from S. Line

Ft. from E. Line

660 Ft. from W. Line

0			

Location

Rig up

Drilling and Remarks:

ND + A

RECORD

Cased _____ in., _____ ft.

Sand TMIL 4175

Gas _____

Oil _____

Total Depth 4235

PRODUCTION

1st 24 hrs. Nat. _____

1st 24 hrs. after shot _____

Gas _____ Cu. Ft.

Dry Hole _____

Abandoned _____

Date

6-19-35 192 _____ Scout

OR 36 241