


KANSAS

Butler county
O.W.D.D

Section 10 Township 28 Range 6-E

Well No. #1, Gilson

Company Rex and Morris

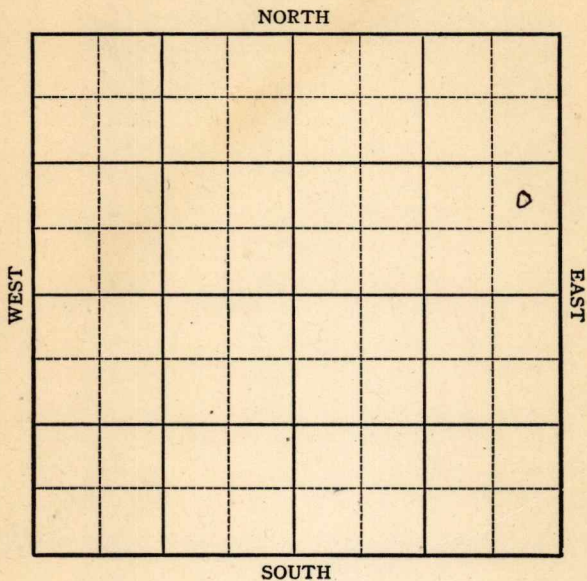

KANSAS

O.W.D.D. Butler county


Sec. 10 Twp. 28 R. 6-E

Well No. #1, Gilson Farm

Rex and Morris Company

Miscellaneous

Ft. from N. Line

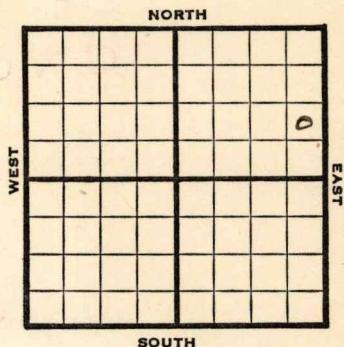

990' Ft. from S. Line

330' Ft. from E. Line

Ft. from W. Line

NE SE NE

1946

REPORT

Elev. 1352'

10/2 Machine

10/8 Drlg 760'

10/15 15" @ 125'

13" @ 8021

10" @ 1560'

Drlg 1640'

10/22 Drlg 2570'

10/30 Miss 2675'

7" @ 2705'

TD 2746'

Pump 50 POT

39 Grav.

COMPLETED

O.W.D.D

1953

9/9 Miss 2675

OTD 2675

7" @ 2705'

Drlg 2900' to DD to Simp & Arb.

9/16 Oil Well

TD 2978'

Miss 2675,

OTD 2745'

7" @ 2705'

KH 2903, Viola 2973

OVER

1953

Information brought forward.

9/16

TD 2978'

FU 250' oil 340' wtr.


Comp. 10 bopd 20 bw.

COMPLETED

Kansas Pool Name MiscellaneousMap No. 77 Sec. 10 Twp. 28 R. 6EWell No. 1 GilsonRex & Morris CompanyFIRST REPORT Contractor

NE SE NE

SECTION PLAT

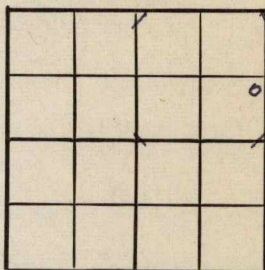 Ft. from N. Line990 Ft. from S. Line330 Ft. from E. Line Ft. from W. LineButler CountyLocation Rig up

Drilling and Remarks:

Machine

RECORD

Cased in., ft.Sand Gas Oil Total Depth

PRODUCTION

1st 24 hrs. Nat. 1st 24 hrs. after shot Gas Cu. Ft.Dry Hole Abandoned

Date

OCT 2 1946 19S. J. LEWIS Scout

Map No. 11 Sec. 10 Twp. 28 R. 6EWell No. 1 GilsonRex & Morris Company**COMPLETED**

Contractor

NE SE NE

E11/352
SECTION PLAT Ft. from N. Line990 Ft. from S. Line330 Ft. from E. Line Ft. from W. Line

			0

Butler County

Location Rig up

Drilling and Remarks:

*Miss 2625**2" @ 2705**Pump 50 ft**39° 30'***RECORD**Cased in., ft.Sand Gas Oil Total Depth 2746**PRODUCTION**1st 24 hrs. Nat. 1st 24 hrs. after shot Gas Cu. Ft.Dry Hole Abandoned

Date

OCT 30 1946

19

S. J. LEWIS

Scout

J. G. McGEHEE