


KANSAS

Map No. Sec. 14 Twp. 32 R. 2E

Well No. 4- F. Barnes Farm  
Kokana Pet Corp Company

NORTH

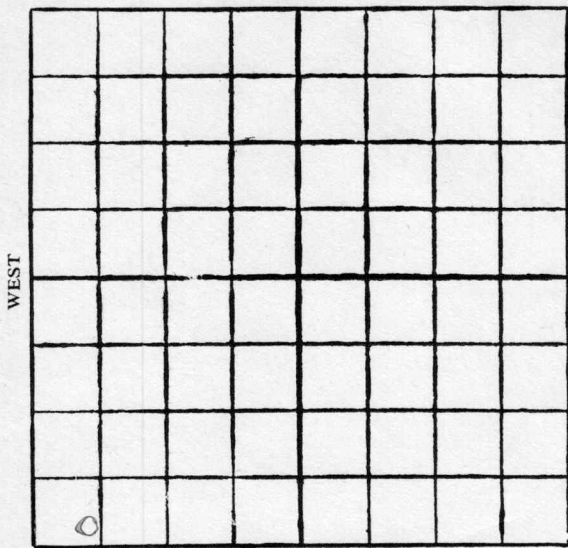

SOUTH

Location .....

Drilling Remarks

Rig Up.....

Drilling Remarks

RECORD

Cased..... in. .... ft.

Sand .....

Gas .....

Oil .....

Total Depth.....

PRODUCTION

1st 24 hrs. Nat.....

1st 24 hrs. after shot.....

Gas..... cu. ft.

Dry Hole.....

Abandoned.....

KANSAS

Map No. \_\_\_\_\_ Sec. 14 Twp. 32 R. 2E

Well No. 4-J. Barnes Farm

Roxana Pet Company


NORTH

\_\_\_\_\_ Ft. from N. Line

220 Ft. from S. Line

\_\_\_\_\_ Ft. from E. Line

645 Ft. from W. Line

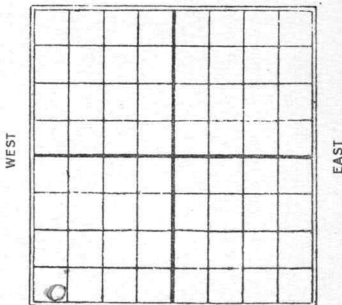

SOUTH

1928

Date	REPORT
3/14	R.O.G.
3/21	Rig
3/28	Drlg 375
4/4	" 775
4/11	" 1560
4/18	Top sand 2046 - drlg 2127-
4/25	T.S. 2046 T.D. 2127
	140/2056-2125'
	swabbed 600 bbls
	24 hrs

Map No. **KANSAS** Sec. 14 Twp. 32 R. 2E7

Well No. 4 F. Barnes

Roxana P. O. Corp. Company

Contractor

**SECTION PLAT**

----- Ft. from N. Line

220 Ft. from S. Line

----- Ft. from E. Line

645 Ft. from W. Line

0			

**FIRST REPORTS**

Location -----

Rig up -----

Drilling and Remarks:

ROY

**RECORD**

Cased \_\_\_\_\_ in., \_\_\_\_\_ ft.

Sand -----

Gas -----

Oil -----

Total Depth -----

**PRODUCTION**

1st 24 hrs. Nat. -----

1st 24 hrs. after shot -----

Gas ----- Cu. Ft.

Dry Hole -----

Abandoned -----

Date

MAR 14 1928

S. J. LEWIS Scout

Map No. **KANSAS** Sec. 14 Twp. 32 R. 2E

Well No. 4 Barnes

Roxana P. & Co. Company

Contractor

**SECTION PLAT**

0			

----- Ft. from N. Line

220 Ft. from S. Line

----- Ft. from E. Line

645 Ft. from W. Line

**COMPLETED**

Location -----

Rig up -----

Drilling and Remarks:

T.S. 2046

T.D. 2127

140/2056-2125

Swapped 600 yds

24 hrs

**RECORD**

Cased \_\_\_\_\_ in, \_\_\_\_\_ ft.

Sand -----

Gas -----

Oil -----

Total Depth -----

**PRODUCTION**

1st 24 hrs. Nat. -----

1st 24 hrs. after shot -----

Gas ----- Cu. Ft.

Dry Hole -----

Abandoned -----

Date

APR 25 1928

S. J. LEWIS

Scout