


Section 9 Township 18 Range 18W

Well No. 1 Young

Company Rupp-Ferguson

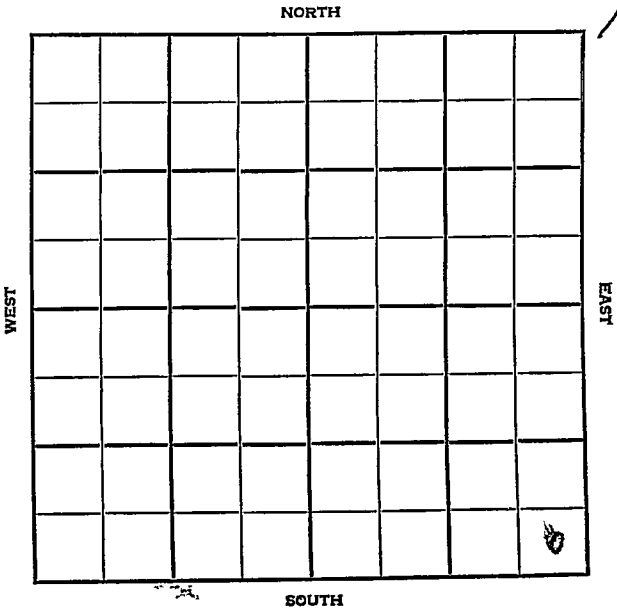

Rush

KANSAS

SEC	9	TWP.	18	R.	18W
-----	---	------	----	----	-----

WELL NO.

1 Young

FARM

COMPANY

Rupp-Ferguson

CONTRACTOR

Co. tools

Wildcats

Ft. from N. Line


330

Ft. from S. Line

330

Ft. from E. Line

Ft. from W. Line

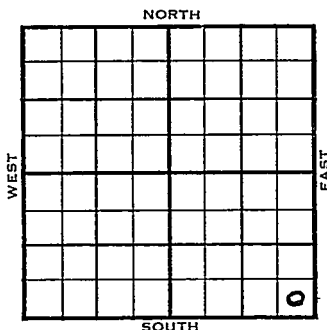SE SE S^E

1954	ELEVATION	REPORT
	2081'	

6/2


MIR

6/9

Spud 5-29-54 D & A TD 3900'
 8" @ 1010 Heeb 3426' Tor. 3444'
 Lans. 3479 B KC 3746 Arb. 3876
 TD 3900' D & A

ABANDONED

County Rush State Kansas
 Sec. 9 (Blk. Twp.) 18 (Sur. Rge.) 18W Map No. _____
 Operator Rupp-Ferguson
 Well No. 1 Farm Young
 Elev. _____ Location SE SE SE

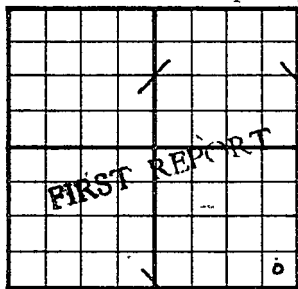

330 Ft. From S Line SE
330 Ft. From E Line Quarter

Ist. Report JUN 2 1954

Completion _____

Remarks _____

Co. tools


Spudding Date _____

Wildcat

Drlg. Data _____

M I R

County Rush State Kansas
 Sec. 9 (Blk. 18) (Sur. 18W) Map No.
 Operator Rupp-Ferguson
 Well No. 1 Farm Young
 Elev. 2081 Location SESE SE

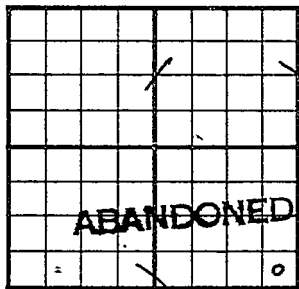

330 Ft. From S Line SE
330 Ft. From E Line Quarter
 Ist. Report JUN 9 1954
 Completion
 Remarks Wildcat
Co. tools
 Spudding Date 5-29-54

Drlg. Data D & A TD 3900
8" @ 1010 Heeb. 3426 Tor. 3444
Lans. 3479 B KC 3746 Arb. 3876 TD 3900
D & A

J. G. McGEHEE